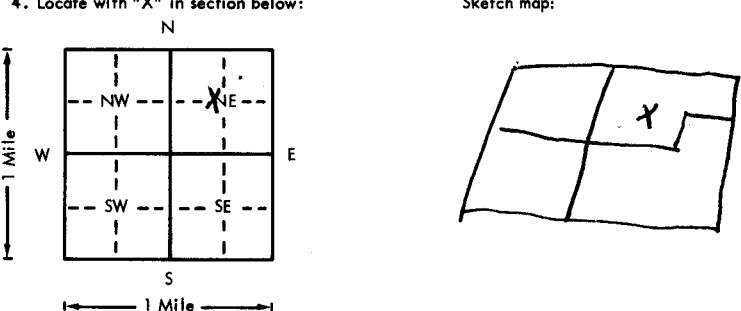



USE TYPEWRITER OR BALL POINT PEN-PRESS FIRMLY, PRINT CLEARLY.

ABD

WATER WELL RECORD
KSA 82a-1201-1215

Kansas Department of Health and Environment-Division of Environment
(Water well Contractors)
Topeka, Kansas 66620

1. Location of well: County SHERMAN Fraction SE NW NE Section number 14 Township number T 9 S R 40 E W	
2. Distance and direction from nearest town or city: 4 1/2 miles south 3. Owner of well: Lucy Howe	
Street address of well location if in city: 1 1/2 W of GOODLAND, R.R. or street: GOODLAND, KANSAS City, state, zip code: 67735	
4. Locate with "X" in section below: Sketch map: 	
5. Type and color of material	
	From To
Top soil & clay	0 203
Gravel	203 209
Sandstone & gravel	209 211
Gravel	211 215
Clay	215 222
Gravel	222 234
Clay & gravel	234 238
Gravel	238 244
Soapstone	244 252
Shale	252 256
(Use a second sheet if needed)	
18. Elevation: 3725 (TOTO)	19. Remarks:
Topography: <input checked="" type="checkbox"/> Hill <input type="checkbox"/> Slope <input type="checkbox"/> Upland <input type="checkbox"/> Valley	
6. Bore hole dia 2 1/2 in. Completion date 7-7-76 Well depth 256 ft.	
7. Cable tool <input type="checkbox"/> Rotary <input type="checkbox"/> Driven <input type="checkbox"/> Dug <input type="checkbox"/> Hollow rod <input type="checkbox"/> Jetted <input type="checkbox"/> Bored <input checked="" type="checkbox"/> Reverse rotary	
8. Use: <input type="checkbox"/> Domestic <input type="checkbox"/> Public supply <input type="checkbox"/> Industry <input checked="" type="checkbox"/> Irrigation <input type="checkbox"/> Air conditioning <input type="checkbox"/> Stock <input type="checkbox"/> Lawn <input type="checkbox"/> Oil field water <input type="checkbox"/> Other	
9. Casing: Material Steel Height: Above or below Threaded <input type="checkbox"/> Welded <input checked="" type="checkbox"/> Surface 8 in. RMP <input type="checkbox"/> PVC <input type="checkbox"/> Weight 32 lbs./ft. Dia. 8 in. to 256 ft. depth Wall Thickness: inches or Dia. <input type="checkbox"/> in. to <input type="checkbox"/> ft. depth Gage No. 138	
10. Screen: Manufacturer's name W.A.B. Brown Type Mill slot Dia. 1 1/2 Slot/gauze 1/8 Length 100' Set between 156 ft. and 256 ft. ft. and <input type="checkbox"/> ft. Gravel pack? <input checked="" type="checkbox"/> Size range of material 1/2 to 3/4	
11. Static water level: 160 ft. below land surface Date 7-10-76 mo./day/yr.	
12. Pumping level below land surfaces: 180 ft. after 8 hrs. pumping 360 g.p.m. 240 ft. after 16 hrs. pumping 408 g.p.m. Estimated maximum yield 408 g.p.m.	
13. Water sample submitted: <input checked="" type="checkbox"/> Yes <input type="checkbox"/> No Date	
14. Well head completion: <input type="checkbox"/> Pitless adapter <input type="checkbox"/> Inches above grade	
15. Well grouted? <input checked="" type="checkbox"/> With: <input type="checkbox"/> Neat cement <input checked="" type="checkbox"/> Bentonite <input type="checkbox"/> Concrete Depth: From 20 ft. to 8" Above	
16. Nearest source of possible contamination: ft. _____ Direction _____ Type _____ Well disinfected upon completion? <input type="checkbox"/> Yes <input type="checkbox"/> No	
17. Pump: Not installed Manufacturer's name T.A.T. AYC Model number 2A176 HP 100 Volts _____ Length of drop pipe 240 ft. capacity 408 g.p.m. Type: <input type="checkbox"/> Submersible <input checked="" type="checkbox"/> Turbine <input type="checkbox"/> Jet <input type="checkbox"/> Reciprocating <input type="checkbox"/> Centrifugal <input type="checkbox"/> Other	
20. Water well contractor's certification: This well was drilled under my jurisdiction and this report is true to the best of my knowledge and belief. Fast Supply Co Inc 144 Business name _____ License No. _____ Address Box 338 Goodland, Kas Signed Robert E. ... Date 10-14-76 Authorized representative	

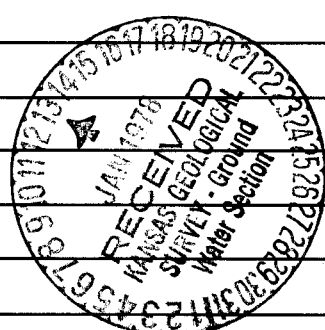

- 6
R
408
14 SE
1/4
1/4
1/4