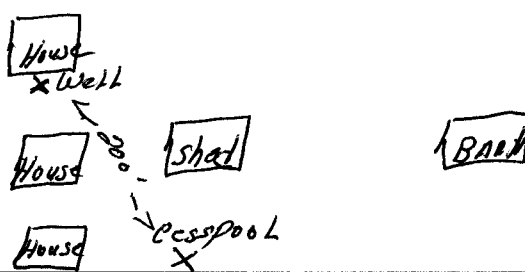


USE TYPEWRITER OR BALL POINT PEN-PRESS FIRMLY, PRINT CLEARLY.

WATER WELL RECORD
KSA 82a-1201-1215

Kansas Department of Health and Environment-Division of Environment
(Water well Contractors)
Topeka, Kansas 66620

BPA **BDC**

1. Location of well: County <u>Sherman</u>		Fraction <u>SW 1/4 NW 1/4 NW 1/4</u>	Section number <u>27</u>	Township number <u>T 9</u>	Range number <u>S R 40 A W</u>	
2. Distance and direction from nearest town or city: <u>Goodland</u> Street address of well location if in city: <u>653 W 1/4 S</u>			3. Owner of well: <u>Fred DARNAUER</u> R.R. or street: <u>RT 1 Box 85</u> City, state, zip code: <u>Goodland Kansas 67235</u>			
4. Locate with "X" in section below: N W E S 1 Mile		Sketch map: 		6. Bore hole dia. <u>9</u> in. Completion date _____ Well depth <u>280</u> . <u>9-1-76</u>		
5. Type and color of material		From	To	7. <input type="checkbox"/> Cable tool <input checked="" type="checkbox"/> Rotary <input type="checkbox"/> Driven <input type="checkbox"/> Dug <input type="checkbox"/> Hollow rod <input type="checkbox"/> Jetted <input type="checkbox"/> Bored <input type="checkbox"/> Reverse rotary		
		<u>GRAVEL</u>	<u>150</u>	<u>172</u>	8. Use: <input checked="" type="checkbox"/> Domestic <input type="checkbox"/> Public supply <input type="checkbox"/> Industry <input type="checkbox"/> Irrigation <input type="checkbox"/> Air conditioning <input type="checkbox"/> Stock <input type="checkbox"/> Lawn <input type="checkbox"/> Oil field water <input type="checkbox"/> Other	
		<u>FINE SAND, GRAVEL, SANDY CLAY</u>	<u>172</u>	<u>209</u>	9. Casing: Material <u>PLASTIC</u> Height: Above or below Threaded <input type="checkbox"/> Welded <input type="checkbox"/> Surface <u>12</u> in. RMP <input type="checkbox"/> PVC <input checked="" type="checkbox"/> Weight _____ lbs./ft. Dia. <u>5</u> in. to <u>252</u> ft. depth Wall Thickness: inches or Dia. _____ in. to _____ ft. depth gage No. <u>250</u>	
		<u>M GRAVEL, SANDY CLAY, SANDSTONE</u>	<u>209</u>	<u>219</u>	10. Screen: Manufacturer's name <u>Jess + Lowell</u> Type <u>Louver</u> Dia. <u>5</u> Slot/gauze <u>1/8</u> Dia. <u>200</u> Length <u>28</u> Set between <u>252</u> ft. and <u>280</u> ft. Gravel pack? <u>YES</u> Size range of material <u>1/8</u>	
		<u>FINE SAND, SANDSTONE</u>	<u>219</u>	<u>248</u>	11. Static water level: _____ mo./day/yr. <u>155</u> ft. below land surface Date <u>8-20-76</u>	
		<u>FINE SAND, GRAVEL, SANDY CLAY</u>	<u>248</u>	<u>265</u>	12. Pumping level below land surfaces: <u>195</u> ft. after <u>5</u> hrs. pumping <u>30</u> g.p.m. _____ ft. after _____ hrs. pumping _____ g.p.m. Estimated maximum yield <u>50</u> g.p.m.	
		<u>M GRAVEL, SANDY CLAY</u>	<u>265</u>	<u>276</u>	13. Water sample submitted: _____ mo./day/yr. Yes <input checked="" type="checkbox"/> No <input type="checkbox"/> Date _____	
		<u>DEBRIS</u>	<u>276</u>	<u>280</u>	14. Well head completion: <input checked="" type="checkbox"/> Pitless adapter <u>12</u> inches above grade	
					15. Well grouted? <u>YES</u> With: <input type="checkbox"/> Neat cement <input type="checkbox"/> Bentonite <input checked="" type="checkbox"/> Concrete Depth: From <u>5</u> ft. to <u>15</u> ft.	
					16. Nearest source of possible contamination: <u>Cess</u> ft. <u>300</u> Direction <u>SE</u> Type <u>POOL</u> Well disinfected upon completion? <input checked="" type="checkbox"/> Yes <input type="checkbox"/> No	
			17. Pump: _____ Not installed Manufacturer's name <u>Red Jacket</u> Model number <u>12 EC</u> HP <u>3</u> Volts <u>230</u> Length of drop pipe <u>273</u> ft. capacity <u>50</u> g.p.m. Type: <input checked="" type="checkbox"/> Submersible <input type="checkbox"/> Turbine <input type="checkbox"/> Jet <input type="checkbox"/> Reciprocating <input type="checkbox"/> Centrifugal <input type="checkbox"/> Other			
18. Elevation:	19. Remarks: <u>3736 (TOP)</u>		20. Water well contractor's certification: This well was drilled under my jurisdiction and this report is true to the best of my knowledge and belief. <u>AH Pulling Co Inc</u> License No. <u>1666</u> Business name <u>Goodland Kan.</u> Address <u>Goodland Kan.</u> Signed <u>Bill Clifford</u> Date <u>9-1-76</u> Authorized representative			

T
R
E
S
E
C
1/4
1/4
1/4