

WATER WELL RECORD Form WWC-5 1221570


Original Record Correction Change in Well Use

Division of Water Resources App. No.

Well ID boxes

1 LOCATION OF WATER WELL: County: Fraction Section Number Township Number Range Number

2 WELL OWNER: Last Name: Business: Address: City: State: ZIP: Street or Rural Address where well is located

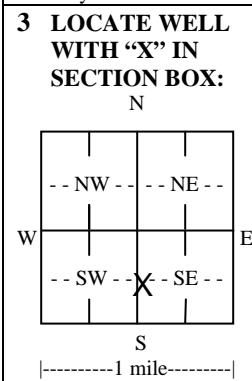

3 LOCATE WELL WITH "X" IN SECTION BOX: 4 DEPTH OF COMPLETED WELL: Depth(s) Groundwater Encountered: WELL'S STATIC WATER LEVEL:

5 Latitude: Longitude: Datum: Source for Latitude/Longitude: GPS (unit make/model): (WAAS enabled? Yes No) Land Survey Topographic Map Online Mapper:

6 Elevation: Ground Level TOC Source: Land Survey GPS Topographic Map Other

7 WELL WATER TO BE USED AS: 1. Domestic: Household Lawn & Garden Livestock Irrigation Feedlot Industrial 2. Public Water Supply: well ID Dewatering: how many wells? Aquifer Recharge: well ID Monitoring: well ID Environmental Remediation: well ID Air Sparge Soil Vapor Extraction Recovery Injection 3. Oil Field Water Supply: lease 4. Test Hole: well ID Cased Uncased Geotechnical 5. Geothermal: how many bores? a) Closed Loop Horizontal Vertical b) Open Loop Surface Discharge Inj. of Water 6. Other (specify):

Was a chemical/bacteriological sample submitted to KDHE? Yes No If yes, date sample was submitted: Water well disinfected? Yes No

8 TYPE OF CASING USED: Steel PVC Other CASING JOINTS: Glued Clamped Welded Threaded Casing diameter: in. to ft., Diameter: in. to ft., Diameter: in. to ft. Casing height above land surface: in. Weight: lbs./ft. Wall thickness or gauge No. TYPE OF SCREEN OR PERFORATION MATERIAL: Steel Stainless Steel Fiberglass PVC Other (Specify) Brass Galvanized Steel Concrete tile None used (open hole) SCREEN OR PERFORATION OPENINGS ARE: Continuous Slot Mill Slot Gauze Wrapped Torch Cut Drilled Holes Other (Specify) Louvered Shutter Key Punched Wire Wrapped Saw Cut None (Open Hole) SCREEN-PERFORATED INTERVALS: From ft. to ft., From ft. to ft., From ft. to ft. GRAVEL PACK INTERVALS: From ft. to ft., From ft. to ft., From ft. to ft.

9 GROUT MATERIAL: Neat cement Cement grout Bentonite Other Grout Intervals: From ft. to ft., From ft. to ft., From ft. to ft. Nearest source of possible contamination: Septic Tank Lateral Lines Pit Privy Livestock Pens Insecticide Storage Sewer Lines Cess Pool Sewage Lagoon Fuel Storage Abandoned Water Well Watertight Sewer Lines Seepage Pit Feedyard Fertilizer Storage Oil Well/Gas Well Other (Specify): Direction from well? Distance from well? ft.

Table with 6 columns: FROM, TO, LITHOLOGIC LOG, FROM, TO, LITHO. LOG (cont.) or PLUGGING INTERVALS. Includes a Notes section.

11 CONTRACTOR'S OR LANDOWNER'S CERTIFICATION: This water well was constructed, reconstructed, or plugged under my jurisdiction and was completed on (mo-day-year) and this record is true to the best of my knowledge and belief. Kansas Water Well Contractor's License No. This Water Well Record was completed on (mo-day-year) under the business name of

Form	WWC5
Contractor	Woofter Pump and Well, Inc.
Well Owner	Matt Hall
Doc ID	1221570

Litholgy

From	To	LithologicLog
0	2	surface
2	21	loess
21	42	clay silty clay & caliche lenses
42	55	caliche w/sand lenses
55	58	med sand
58	70	clat w/caliche lenses & sand lenses
70	70.5	caliche
70.5	89	med sand/clay lenses
89	106	med sand some gravel
106	123	clay caliche & fine sand lenses
123	143	med sand some gravel
143	148	clay & caliche
148	150	caliche
150	153	clay & caliche
153	161	silty clay & sand strks
161	175	silty clay & sand strks
175	178	med sand
178	181	caliche
181	193	fine sand w/clay
193	198	med sand
198	199	caliche
199	204	fine and & clay

Form	WWC5
Contractor	Woofter Pump and Well, Inc.
Well Owner	Matt Hall
Doc ID	1221570

Litholgy

From	To	LithologicLog
204	217	caliche & clay & sand lenses
217	225	med sand
225	226	caliche
226	228	med sand
228	235	caliche w/sand lenses
235	241	churt w/clay strks semi hard
241	254	med sand
254	255	hard layer
255	258	fine sand to med loose
258	261	med sand
261	267	fine to med sand w/clay lenses
267	270	clay & caliche
270	273	med sand
273	275	clay w/sand strks
275	278	med sand w/clay lenses
278	284	clay & caliche sand strks
284	290	caliche clay & sand lenses
290	295	med sand
295	300	ochre & shale