

USE TYPEWRITER OR BALL POINT PEN-PRESS FIRMLY, PRINT CLEARLY.

T R EW sec 1/4 1/4 1/4 No.

WATER WELL RECORD
KSA 82a-1201-1215


Kansas State Dept. Of Health
(Water Well Contractors)
Forbes-Bldg. 740
Topeka, Kansas 66620

NE SW CCA

1 Location of well: County SHERMAN Township name LINCOLN Fraction SW 1/4 Section number 4 Town number 9 Range number 41

Distance and direction from nearest town or city: RULETON, KANSAS
Street address of well location if in city: 3 miles 1 mile west SOUTH

3 Owner of well: RALPH WILSON
Address: RULETON, KANS.

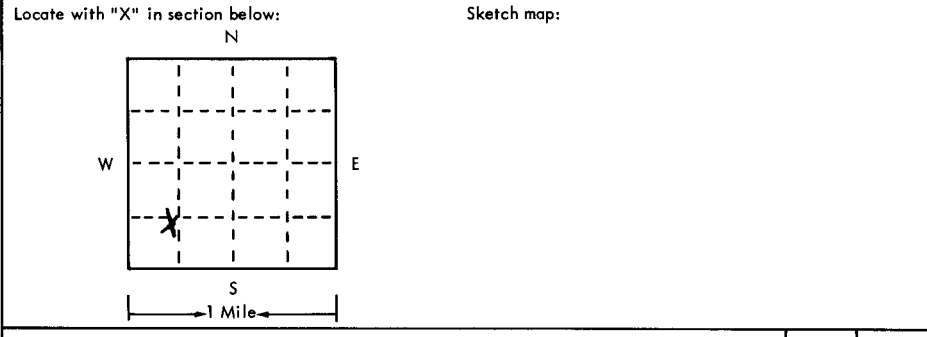

4 Well depth: 292 ft. Date of completion 3-25-75
Well diameter 16 in.

5 Cable tool Rotary Driven Dug
 Hollow rod Jetted Bored Reverse rotary

6 Use: Domestic Public supply Industry
 Irrigation Air conditioning Commercial
 Test well

7 Casing: Material Steel Height: above/below
Threaded Welded Surface 8 in.
Diam. 16 in. Weight 27 lbs./ft.
16 in. to 292 ft. depth! Drive shoe? Yes No
___ in. to ___ ft. depth!

2	Type and color of material	From	To
	Sand	160	161
	Hard Sandstone	161	167
	Gravel	167	168
	Sandy clay	168	178
	Gravel	178	188
	Sandy clay	188	191
	Gravel	191	194
	Clay	194	216
	Gravel	216	229
	Gravel & Clay	229	240
	Clay	240	255
	Gravel	255	261
	Sandstone	261	264
	Gravel	264	287
	Soapstone	287	292
	Shale	292	

8 Screen: Manufacturer W.A. Brown
Type Mill slot Dia. 16"
Slot/gauze 1/8 Length 2 1/2"
Set between 172 ft. and 292 ft.
Fittings: Gravel pack Yes No Size range of material 1/2"

9 Static water level: 160 ft. below land surface Date 3-15-75

10 Pumping level below land surfaces:
240 ft. after 8 hrs. pumping 225 g.p.m.
___ ft. after ___ hrs. pumping ___ g.p.m.
Estimated maximum yield 225 g.p.m.

11 Water sample submitted:
 Yes No Date _____

12 Well head completion:
 Pitless adapter Inches above grade

13 Well grouted? Yes No
 Neat cement Bentonite _____
Depth: From ___ ft. to ___ ft.

14 Nearest source of possible contamination:
ft. _____ Direction _____ Type _____
Well disinfected upon completion? Yes No

15 Pump: Not installed
Manufacturer's name Johnston
Model number _____ HP 100 Volts 460
Length of drop pipe 280 ft. capacity 200 g.p.m.
Type:
 Submersible Turbine
 Jet Reciprocating
 Centrifugal Other

16 Remarks: elevation 3844 (1000)

Topography:
 Hill
 Slope
 Upland
 Valley

17 Water well contractor's certification:
This well was drilled under my jurisdiction and this report is true to the best of my knowledge and belief.
FOUST SUPPLY Co. Inc. 144
Business name License No. _____
Address Box 338 Doodland, Kans.
Signed Ralph Wilson Date 3-25-75
Authorized representative