


WATER WELL RECORD Form WWC-5 KSA 82a-1212

1] LOCATION OF WATER WELL: County: <u>Sherman</u>	Fraction <u>NW 1/4 NE 1/4</u>	Section Number <u>15</u>	Township Number <u>T 9 S</u>	Range Number <u>R 41 EW</u>
--	----------------------------------	-----------------------------	---------------------------------	--------------------------------

Distance and direction from nearest town or city street address of well if located within city?  
legal confirmed by CMD 4

2] WATER WELL OWNER: Bill Cannon  
 RR#, St. Address, Box #: Box 3  
 City, State, ZIP Code: Goodland, KS 67735  
 Board of Agriculture, Division of Water Resources  
 Application Number:

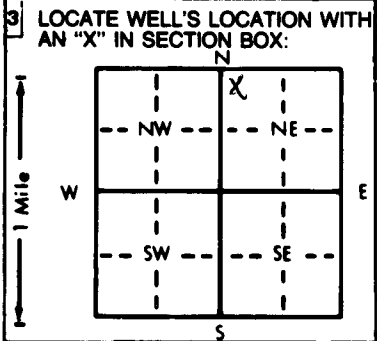

4] DEPTH OF COMPLETED WELL: unk ft. ELEVATION: \_\_\_\_\_ ft.  
 Depth(s) Groundwater Encountered 1. \_\_\_\_\_ ft. 2. \_\_\_\_\_ ft. 3. \_\_\_\_\_ ft.  
 WELL'S STATIC WATER LEVEL unk ft. below land surface measured on mo/day/yr \_\_\_\_\_  
 Pump test data: Well water was \_\_\_\_\_ ft. after \_\_\_\_\_ hours pumping \_\_\_\_\_ gpm  
 Est. Yield \_\_\_\_\_ gpm; Well water was \_\_\_\_\_ ft. after \_\_\_\_\_ hours pumping \_\_\_\_\_ gpm  
 Bore Hole Diameter \_\_\_\_\_ in. to \_\_\_\_\_ ft., and \_\_\_\_\_ in. to \_\_\_\_\_ ft.  
 WELL WATER TO BE USED AS:  
 1 Domestic     3 Feedlot     6 Oil field water supply     9 Dewatering     12 Other (Specify below)  
 2 Irrigation     4 Industrial     7 Lawn and garden only     10 Monitoring well  
 Was a chemical/bacteriological sample submitted to Department? Yes \_\_\_\_\_ No \_\_\_\_\_; If yes, mo/day/yr sample was submitted \_\_\_\_\_  
 Water Well Disinfected? Yes \_\_\_\_\_ No \_\_\_\_\_

5] TYPE OF BLANK CASING USED:  
 1 Steel     3 RMP (SR)     5 Wrought iron     8 Concrete tile    CASING JOINTS: Glued \_\_\_\_\_ Clamped \_\_\_\_\_  
 2 PVC     4 ABS     6 Asbestos-Cement     9 Other (specify below)    Welded \_\_\_\_\_  
 \_\_\_\_\_     \_\_\_\_\_     7 Fiberglass    \_\_\_\_\_    Threaded \_\_\_\_\_  
 Blank casing diameter S \_\_\_\_\_ in. to \_\_\_\_\_ ft., Dia \_\_\_\_\_ in. to \_\_\_\_\_ ft., Dia \_\_\_\_\_ in. to \_\_\_\_\_ ft.  
 Casing height above land surface \_\_\_\_\_ in., weight \_\_\_\_\_ lbs./ft. Wall thickness or gauge No. \_\_\_\_\_  
 TYPE OF SCREEN OR PERFORATION MATERIAL:  
 1 Steel     3 Stainless steel     5 Fiberglass     8 RMP (SR)     10 Asbestos-cement  
 2 Brass     4 Galvanized steel     6 Concrete tile     9 ABS     11 Other (specify) \_\_\_\_\_  
 12 None used (open hole)  
 SCREEN OR PERFORATION OPENINGS ARE:  
 1 Continuous slot     3 Mill slot     5 Gauzed wrapped     8 Saw cut     11 None (open hole)  
 2 Louvered shutter     4 Key punched     6 Wire wrapped     9 Drilled holes  
 7 Torch cut     10 Other (specify) \_\_\_\_\_  
 SCREEN-PERFORATED INTERVALS: From \_\_\_\_\_ ft. to \_\_\_\_\_ ft., From \_\_\_\_\_ ft. to \_\_\_\_\_ ft.  
 GRAVEL PACK INTERVALS: From \_\_\_\_\_ ft. to \_\_\_\_\_ ft., From \_\_\_\_\_ ft. to \_\_\_\_\_ ft.

6] GROUT MATERIAL:  1 Neat cement     2 Cement grout     3 Bentonite     4 Other \_\_\_\_\_  
 Grout intervals: From 6 ft. to 4 ft., From \_\_\_\_\_ ft. to \_\_\_\_\_ ft., From \_\_\_\_\_ ft. to \_\_\_\_\_ ft.  
 What is the nearest source of possible contamination:  
 1 Septic tank     4 Lateral lines     7 Pit privy     10 Livestock pens     14 Abandoned water well  
 2 Sewer lines     5 Cess pool     8 Sewage lagoon     11 Fuel storage     15 Oil well/Gas well  
 3 Watertight sewer lines     6 Seepage pit     9 Feedyard     12 Fertilizer storage     16 Other (specify below) none

FROM	TO	LITHOLOGIC LOG	FROM	TO	PLUGGING INTERVALS
					<u>removed 4 ft casing</u>
			<u>TD</u>	<u>6</u>	<u>clay</u>
			<u>6</u>	<u>4</u>	<u>cement</u>
			<u>4</u>	<u>0</u>	<u>clay</u>
		<u>volunteer</u>			
					<b>RECEIVED</b>
					FEB 07 1990
					DIVISION OF ENVIRONMENT

7] CONTRACTOR'S OR LANDOWNER'S CERTIFICATION: This water well was (1) constructed, (2) reconstructed, or (3) plugged under my jurisdiction and was completed on (mo/day/year) \_\_\_\_\_ and this record is true to the best of my knowledge and belief. Kansas Water Well Contractor's License No. \_\_\_\_\_ This Water Well Record was completed on (mo/day/yr) 1-5-1990 under the business name of \_\_\_\_\_ by (signature) Bill Cannon

OFFICE USE ONLY  
T  
R  
EW  
SEC.  
1/4  
1/4  
1/4