


USE TYPEWRITER OR BALL POINT PEN-PRESS FIRMLY, PRINT CLEARLY.

RULE 111

DAB WATER WELL RECORD
KSA 82a-1201-1215
NW NE SE

Kansas Department of Health and Environment-Division of Environment
(Water well Contractors)
Topeka, Kansas 66620

1. Location of well: County <u>SHERMAN</u> Fraction <u>S 1/2 S 1/2 SE 1/4</u> Section number <u>15</u> Township number <u>T 9 S</u> Range number <u>R 41 E W</u>	
2. Distance and direction from nearest town or city: <u>5 1/2 1/4 W</u> Street address of well location if in city: <u>Ruleton</u>	
3. Owner of well: <u>Bill Gannon</u> R.R. or street: <u>Rt 2</u> City, state, zip code: <u>Goodland, Kansas</u>	
4. Locate with "X" in section below: Sketch map:	
5. Type and color of material	
	From To
<u>Top soil & clay</u>	0 158
<u>Gravel</u>	158 235
<u>Sand</u>	235 247
<u>Gravel</u>	247 269
<u>Clay</u>	269 273
<u>Gravel</u>	273 275
<u>Clay</u>	275 281
<u>Gravel</u>	281 291
<u>Soapstone</u>	291 296
<u>Shale</u>	296
6. Bore hole dia. <u>24</u> in. Completion date <u>7-2-76</u> Well depth <u>302</u> ft.	
7. <input type="checkbox"/> Cable tool <input type="checkbox"/> Rotary <input type="checkbox"/> Driven <input type="checkbox"/> Dug <input type="checkbox"/> Hollow rod <input type="checkbox"/> Jetted <input type="checkbox"/> Bored <input checked="" type="checkbox"/> Reverse rotary	
8. Use: <input type="checkbox"/> Domestic <input type="checkbox"/> Public supply <input type="checkbox"/> Industry <input checked="" type="checkbox"/> Irrigation <input type="checkbox"/> Air conditioning <input type="checkbox"/> Stock <input type="checkbox"/> Lawn <input type="checkbox"/> Oil field water <input type="checkbox"/> Other	
9. Casing: Material <u>Steel</u> Height: Above or below Threaded <input type="checkbox"/> Welded <input checked="" type="checkbox"/> Surface <u>8</u> in. RMP <input type="checkbox"/> PVC <input type="checkbox"/> Weight <u>32</u> lbs./ft. Dia. <u>8</u> in. to <u>302</u> ft. depth Wall Thickness: inches or Dia. <input type="checkbox"/> in. to <input type="checkbox"/> ft. depth gage No. <u>188</u>	
10. Screen: Manufacturer's name <u>W.A. Brown</u> Type <u>Millsoft</u> Dia. <u>16</u> Slot/gauze <u>1/8</u> Length <u>40</u> Set between <u>182</u> ft. and <u>302</u> ft. Gravel pack? <input checked="" type="checkbox"/> Size range of material <u>1/2"</u>	
11. Static water level: <u>150</u> ft. below land surface Date <u>6-25-76</u> mo./day/yr.	
12. Pumping level below land surfaces: <u>180</u> ft. after <u>8</u> hrs. pumping <u>100</u> g.p.m. <u>280</u> ft. after <u>16</u> hrs. pumping <u>856</u> g.p.m. Estimated maximum yield <u>856</u> g.p.m.	
13. Water sample submitted: <input checked="" type="checkbox"/> Yes <input type="checkbox"/> No Date _____ mo./day/yr.	
14. Well head completion: <input type="checkbox"/> Pitless adapter _____ Inches above grade	
15. Well grouted? <input checked="" type="checkbox"/> With: <input checked="" type="checkbox"/> Neat cement <input checked="" type="checkbox"/> Bentonite <input type="checkbox"/> Concrete Depth: From <u>10</u> ft. to <u>8" ABOVE</u>	
16. Nearest source of possible contamination: ft. _____ Direction _____ Type _____ Well disinfected upon completion? <input type="checkbox"/> Yes <input type="checkbox"/> No	
17. Pump: Not installed. Manufacturer's name <u>AFC TAIT</u> Model number <u>98065MP 115</u> Volts <u>460</u> Length of drop pipe <u>290</u> ft. capacity <u>856</u> g.p.m. Type: <input type="checkbox"/> Submersible <input checked="" type="checkbox"/> Turbine <input type="checkbox"/> Jet <input type="checkbox"/> Reciprocating <input type="checkbox"/> Centrifugal <input type="checkbox"/> Other	
18. Elevation: _____ 19. Remarks: <u>3629 (TUPO)</u>	
20. Water well contractor's certification: This well was drilled under my jurisdiction and this report is true to the best of my knowledge and belief. <u>FOUST SUPPLY CO INC 145</u> Business name License No. Address <u>Box 338 Goodland</u> Signed <u>John E. Foust</u> Date <u>10/23/76</u> Authorized representative	

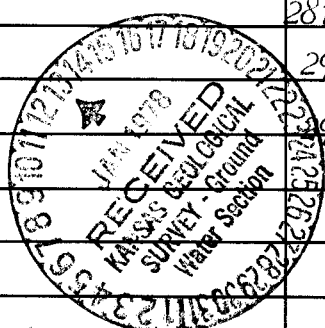

T 9 R 41 E W 1/4 1/4 1/4 NW NE SE