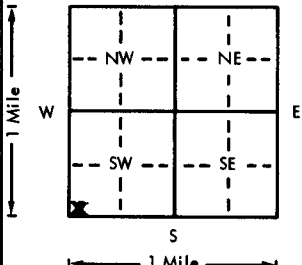


USE TYPEWRITER OR BALL POINT PEN—PRESS FIRMLY, PRINT CLEARLY.

WATER WELL RECORD
KSA 82a-1201-1215

CCB

Kansas Department of Health and Environment—Division of Environment
(Water well Contractors)
Topeka, Kansas 66620

1. Location of well:	County Sherman	Fraction SW 1/4 SW 1/4 SW 1/4	Section number 18	Township number T 9 S R	Range number 41 E 19
2. Distance and direction from nearest town or city 2 west, 4 1/4 south, 3/4 west of Ruleton, Kansas Street address of well location if in city:			3. Owner of well: Milton Parish, Jr. R.R. or street: City, state, zip code: Goodland, Kansas 67735		
4. Locate with "X" in section below: Sketch map: 			6. Bore hole dia. 30 in. Completion date 4-16-76 Well depth 277 ft.		
5. Type and color of material			7. <input type="checkbox"/> Cable tool <input type="checkbox"/> Rotary <input type="checkbox"/> Driven <input type="checkbox"/> Dug <input type="checkbox"/> Hollow rod <input type="checkbox"/> Jetted <input type="checkbox"/> Bored <input checked="" type="checkbox"/> Reverse rotary		
			8. Use: <input type="checkbox"/> Domestic <input type="checkbox"/> Public supply <input type="checkbox"/> Industry <input checked="" type="checkbox"/> Irrigation <input type="checkbox"/> Air conditioning <input type="checkbox"/> Stock <input type="checkbox"/> Lawn <input type="checkbox"/> Oil field water <input type="checkbox"/> Other		
From			9. Casing: Material steel Height: Above or below Threaded <input type="checkbox"/> Welded <input checked="" type="checkbox"/> Surface 12 in. RMP <input type="checkbox"/> PVC <input type="checkbox"/> Weight 36 lbs./ft. Dia 16 in. to 277 ft. depth Wall Thickness: inches or Dia. <input type="checkbox"/> in. to <input type="checkbox"/> ft. depth gage No. 219		
			10. Screen: Manufacturer's name W. A. Brown Type steel Dia. 16" Slot/gauze 2" Length 130' Set between 147 ft. and 277 ft. <input type="checkbox"/> ft. and <input type="checkbox"/> ft. Gravel pack? yes Size range of material 1/4"		
18. Elevation: Topography: <input type="checkbox"/> Hill <input checked="" type="checkbox"/> Slope <input type="checkbox"/> Upland <input type="checkbox"/> Valley			11. Static water level: <input type="checkbox"/> mo./day/yr. 150 ft. below land surface Date 4-30-76		
			12. Pumping level below land surfaces: 220 ft. after 8 hrs. pumping 682 g.p.m. <input type="checkbox"/> ft. after <input type="checkbox"/> hrs. pumping <input type="checkbox"/> g.p.m. Estimated maximum yield 682 g.p.m.		
19. Remarks: 3852 (TOTO) 3852			13. Water sample submitted: <input type="checkbox"/> mo./day/yr. Yes <input checked="" type="checkbox"/> No <input type="checkbox"/> Date <input type="checkbox"/>		
			14. Well head completion: <input type="checkbox"/> Pitless adapter 12 Inches above grade		
20. Water well contractor's certification: This well was drilled under my jurisdiction and this report is true to the best of my knowledge and belief. Northwest Drilling Co., Inc. Business name Box 411, E Goodland, Kansas License No. 1248 Address 1/2 10/14 0773 Signed Ben Hark Date 8-3-76 Authorized representative			15. Well grouted? yes With: <input checked="" type="checkbox"/> Neat cement <input type="checkbox"/> Bentonite <input type="checkbox"/> Concrete Depth: From 0 ft. to 10 ft.		
			16. Nearest source of possible contamination: none ft. <input type="checkbox"/> Direction <input type="checkbox"/> Type <input type="checkbox"/> Well disinfected upon completion? <input type="checkbox"/> Yes <input type="checkbox"/> No		
(Use a second sheet if needed)			17. Pump: <input type="checkbox"/> Not installed Manufacturer's name Gould Model number Turbine HP <input type="checkbox"/> Volts <input type="checkbox"/> Length of drop pipe 270 ft. capacity 600 g.p.m. Type: <input type="checkbox"/> Submersible <input checked="" type="checkbox"/> Turbine <input type="checkbox"/> Jet <input type="checkbox"/> Reciprocating <input type="checkbox"/> Centrifugal <input type="checkbox"/> Other		
			18. Elevation: Topography: <input type="checkbox"/> Hill <input checked="" type="checkbox"/> Slope <input type="checkbox"/> Upland <input type="checkbox"/> Valley		

T-6
R-7
E-8
S-9
10773
1/2 10/14