

USE TYPEWRITER OR BALL POINT PEN-PRESS FIRMLY, PRINT CLEARLY.

RULETON

T	R	EW	sec 1/4	1/4	1/4	No.
---	---	----	---------	-----	-----	-----


WATER WELL RECORD
KSA 82a-1201-1215

~~BDA~~ BDA

Kansas State Dept. Of Health
(Water Well Contractors)
Forbes-Bldg. 740
Topeka, Kansas 66620

1 Location of well:	County SHERMAN	Township name LINCOLN	Fraction SE 1/4 NW 1/4	Section number 21	Town number 9	Range number 41
---------------------	--------------------------	---------------------------------	----------------------------------	-----------------------------	-------------------------	---------------------------

Distance and direction from nearest town or city: RULETON	3 Owner of well: MELVIN WILSON
Street address of well location if in city: 6 S 1/2 W 1/2 N	Address: GOODLAND KANSAS

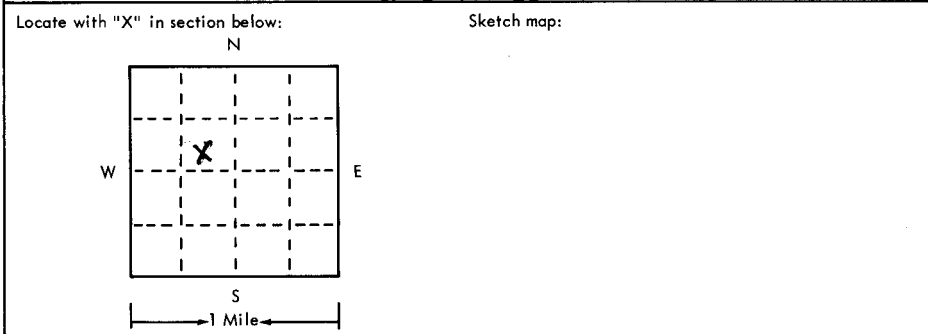

4 Well depth: 310 ft. Date of completion 6-12-75 Well diameter 26 in.
5 <input type="checkbox"/> Cable tool <input type="checkbox"/> Rotary <input type="checkbox"/> Driven <input type="checkbox"/> Dug <input type="checkbox"/> Hollow rod <input type="checkbox"/> Jetted <input type="checkbox"/> Bored <input checked="" type="checkbox"/> Reverse rotary
6 Use: <input type="checkbox"/> Domestic <input type="checkbox"/> Public supply <input type="checkbox"/> Industry <input checked="" type="checkbox"/> Irrigation <input type="checkbox"/> Air conditioning <input type="checkbox"/> Commercial <input type="checkbox"/> Test well
7 Casing: Material Steel Height: above/below Threaded <input type="checkbox"/> Welded <input checked="" type="checkbox"/> Surface 12 in. Diam. 16 in. to 220 ft. depth Drive shoe? <input type="checkbox"/> Yes <input checked="" type="checkbox"/> No Weight 33 lbs./ft. 1

2	Type and color of material	From	To
	M GRAVEL, SANDY CLAY	130	165
	M GRAVEL	165	175
	M GRAVEL, SANDY CLAY	175	203
	Fine Sand, SANDY CLAY, ROCK	203	251
	SANDY CLAY, HARD SANDSTONE	251	261
	M GRAVEL, SANDY CLAY, SANDSTONE	261	279
	M GRAVEL, SANDY CLAY	279	306
	OHRC	306	310
	306 310		

8 Screen: Manufacturer W.A. BROWN Type LUVER Dia. 16 Slot/gauze 1/8 x 7 Length 90 Set between 220 ft. and 310 ft. Fittings: Gravel pack <input checked="" type="checkbox"/> Yes <input type="checkbox"/> No Size range of material 1/4 x 5/8
9 Static water level: 139 ft. below land surface Date 6-13-75

10 Pumping level below land surfaces: 285 ft. after 24 hrs. pumping 250 g.p.m. ____ ft. after ____ hrs. pumping ____ g.p.m. Estimated maximum yield 900 g.p.m.

11 Water sample submitted: <input type="checkbox"/> Yes <input checked="" type="checkbox"/> No Date _____
--

12 Well head completion: <input type="checkbox"/> Pitless adapter <input type="checkbox"/> Inches above grade
--

13 Well grouted? <input checked="" type="checkbox"/> Yes <input type="checkbox"/> No <input checked="" type="checkbox"/> Neat cement <input type="checkbox"/> Bentonite <input type="checkbox"/> _____ Depth: From 0 ft. to 10 ft.
--

14 Nearest source of possible contamination: ft. _____ Direction _____ Type None Well disinfected upon completion? <input type="checkbox"/> Yes <input checked="" type="checkbox"/> No

15 Pump: <input type="checkbox"/> Not installed Manufacturer's name _____ Model number 8M HP 100 Volts 440 Length of drop pipe 290 ft. capacity 250 g.p.m. Type: <input type="checkbox"/> Submersible <input checked="" type="checkbox"/> Turbine <input type="checkbox"/> Jet <input type="checkbox"/> Reciprocating <input type="checkbox"/> Centrifugal <input type="checkbox"/> Other
--

16 Remarks: elevation 3846 (TOP) 3846
Topography: <input type="checkbox"/> Hill <input type="checkbox"/> Slope <input checked="" type="checkbox"/> Upland <input type="checkbox"/> Valley

17 Water well contractor's certification: This well was drilled under my jurisdiction and this report is true to the best of my knowledge and belief. AH Drilling Co Inc 166 Business name _____ License No. _____ Address Goodland Kansas Signed Bill Clifford Date 6-27-75 Authorized representative
--