RULETON SE

USE TYPEWRITER OR BALL POINT PEN-PRESS FIRMLY, PRINT CLEARLY.

WATER WELL RECORD
KSA 82a-1201-1215

DJDD

Kansas Department of Health and Environment-Division of Environment
(Water well Contractors)
Topeka, Kansas 66620

1. Location of well:	County	Fraction	Section number	Township number	Range number
	Sherman	SE 1/4 SE 1/4 SE 1/4	24	T 9 S	R 41 E (W)

2. Distance and direction from nearest town or city: Goodland
Street address of well location if in city: 6 S 6 W

3. Owner of well: Kenneth Towsend
R.R. or street: RT 1
City, state, zip code: Goodland Kansas 67735

4. Locate with "X" in section below:

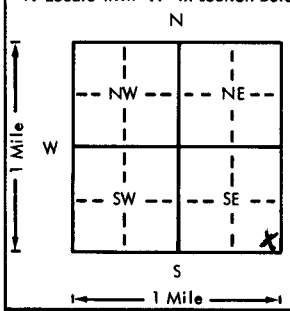

Sketch map:

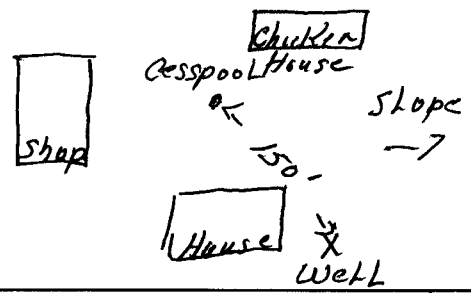

6. Bore hole dia. 26 in. Completion date 9-28-76
Well depth 255 ft.

7. __ Cable tool X Rotary __ Driven __ Dug
__ Hollow rod __ Jetted __ Bored __ Reverse rotary

8. Use: X Domestic __ Public supply __ Industry
__ Irrigation __ Air conditioning __ Stock
__ Lawn __ Oil field water __ Other

9. Casing: Material Plastic Height: Above ~~or below~~
Threaded ___ Welded ___ Surface 12 in.
RMP ___ PVC X Weight ___ lbs./ft.
Dia. 4 in. to 235 ft. depth Wall Thickness: inches or
Dia. ___ in. to ___ ft. depth gage No. .200

5. Type and color of material	From	To
M Gravel, Sandy Clay, Sandstone	167	187
Sandy Clay, Rock	187	197
M Gravel Sandy Clay, Sandstone	197	218
M Gravel	218	229
M Gravel, Sandstone	229	233
Fine Sand, Gravel, Sandy Clay	233	243
M Gravel	243	249
Ochre	249	255
Broken 249'		
(Use a second sheet if needed)		

10. Screen: Manufacturer's name Jess + Lowell
Type Louver Dia. 5"
Slot/gauze 18 .200 Length 20
Set between 235 ft. and 255 ft.
___ ft. and ___ ft.
Gravel pack? yes Size range of material 18

11. Static water level: mo./day/yr.
171 ft. below land surface Date 9-21-76

12. Pumping level below land surfaces:
210 ft. after 3 hrs. pumping 30 g.p.m.
___ ft. after ___ hrs. pumping ___ g.p.m.
Estimated maximum yield 50 g.p.m.

13. Water sample submitted: mo./day/yr.
__ Yes X No Date ___

14. Well head completion:
X Pitless adapter 12 Inches above grade

15. Well grouted? yes
With: ___ Neat cement ___ Bentonite X Concrete
Depth: From 5 ft. to 15 ft.

16. Nearest source of possible contamination: Cess
ft. 150 Direction NW Type Pool
Well disinfected upon completion? X Yes ___ No

17. Pump: ___ Not installed
Manufacturer's name Red Jacket
Model number 11CC HP 1/2 Volts 230
Length of drop pipe 216 ft. capacity 20 g.p.m.
Type:
X Submersible ___ Turbine
___ Jet ___ Reciprocating
___ Centrifugal ___ Other

18. Elevation:

Topography:
___ Hill
___ Slope
X Upland
___ Valley

19. Remarks: 3803 (Toto)

20. Water well contractor's certification:
This well was drilled under my jurisdiction and this report is true to the best of my knowledge and belief.
Business name L+H Drilling Co Inc License No. 166
Address Goodland Kansas
Signed Bill Clifford Date ___
Authorized representative 9-30-76

T 9 R 41 E (W) Sec 24 1/4 SE 1/4 SE 1/4 SE 1/4

Forward the white, blue and pink copies to the Department of Health and Environment

Form WWC-5