

USE TYPEWRITER OR BALL POINT PEN-PRESS FIRMLY, PRINT CLEARLY.


T R EW sec 1/4 1/4 1/4 No.

DAF
WATER WELL RECORD
 KSA 82a-1201-1215
DAC
NE SW SE

Kansas State Dept. Of Health
 (Water Well Contractors)
 Forbes-Bldg. 740
 Topeka, Kansas 66620

1 Location of well: County Sherman Township name Lincoln Fraction SW 1/4 of SE 1/4 Section number 35 Town number 9 Range number 41 W

Distance and direction from nearest town or city: 1 mile east of center of Rubton
 Street address of well location if in city:
 3 Owner of well: Allen Townsend
 Address: Hoodland, Ks 67735

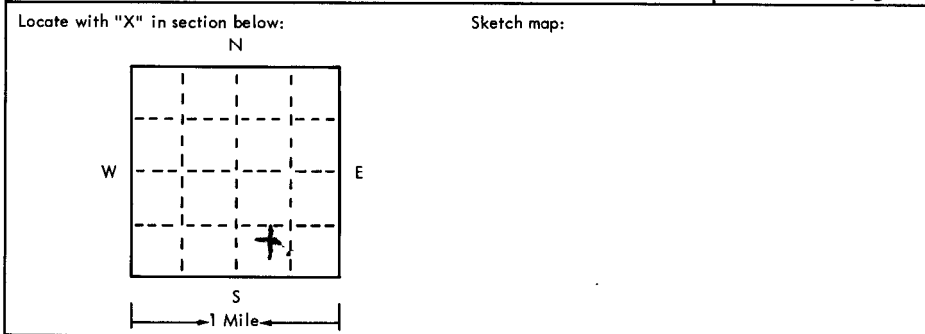

4 Well depth: 230 ft. Date of completion Aug 75
 Well diameter 16 in.
 5 Cable tool Rotary Driven Dug
 Hollow rod Jetted Bored Reverse rotary
 6 Use: Domestic Public supply Industry
 Irrigation Air conditioning Commercial
 Test well
 7 Casing: Material Steel Height: above below
 Threaded Welded Surface 12 in.
 Diam. 16 in. Weight 22 lbs./ft. L
16 in. to 230 ft. depth Drive shoe? Yes No
 ___ in. to ___ ft. depth!

2	Type and color of material	From	To
	<u>top soil and clay</u>		<u>120</u>
	<u>3' cemented gravel 7' loose gravel little sand</u>	<u>120</u>	<u>130</u>
	<u>10' porous rock - strips of sandy clay</u>	<u>130</u>	<u>140</u>
	<u>5' porous rock & clay 3' rock 2' coarse gravel</u>	<u>140</u>	<u>150</u>
	<u>5' coarse gravel 5' porous rock & gravel strips</u>	<u>150</u>	<u>160</u>
	<u>10' porous rock & gravel - strips of clay</u>	<u>160</u>	<u>170</u>
	<u>4' porous rock 6' gravel</u>	<u>170</u>	<u>180</u>
	<u>6' gravel 4' cemented gravel and rock</u>	<u>180</u>	<u>190</u>
	<u>3' cemented gravel 6' loose gravel porous</u>	<u>190</u>	<u>200</u>
	<u>1' porous rock & clay 7' gravel 2' clay</u>	<u>200</u>	<u>210</u>
	<u>10' gravel</u>	<u>210</u>	<u>220</u>
	<u>7' loose gravel 3' shab</u>	<u>220</u>	<u>230</u>

8 Screen: Manufacturer W.A. Brown Enterprises
 Type free flow Dia. 16"
 Slot/gauze 3/16 Length 40'
 Set between 190 ft. and 230 ft.
 Fittings: 3/4"
 Gravel pack Yes No Size range of material ___
 9 Static water level: 140 ft. below land surface Date 9/75

10 Pumping level below land surfaces:
215 ft. after 10 hrs. pumping 900 g.p.m.
 ___ ft. after ___ hrs. pumping ___ g.p.m.
 Estimated maximum yield 900 g.p.m.

11 Water sample submitted:
 Yes No Date ___

12 Well head completion: 12'
 Pitless adapter Inches above grade

13 Well grouted? Yes No Undrilled
 Neat cement Bentonite clay
 Depth: From 0 ft. to 10 ft.

14 Nearest source of possible contamination:
 ft. ___ Direction ___ Type ___
 Well disinfected upon completion? Yes No

15 Pump: Not installed
 Manufacturer's name Stoulds
 Model number 125MC HP ___ Volts ___
 Length of drop pipe ___ ft. capacity ___ g.m.p.
 Type:
 Submersible Turbine
 Jet Reciprocating
 Centrifugal Other

16 Remarks: elevation 3823
 Topography:
 Hill
 Slope
 Upland
 Valley

17 Water well contractor's certification:
 This well was drilled under my jurisdiction and this report is true to the best of my knowledge and belief.
Jack Paredhullig 197
 Business name Madonald License No. ___
 Address Ks
 Signed Jack Paredhullig Date 9-5-75
 Authorized representative

9 41W 35 NE SW SE