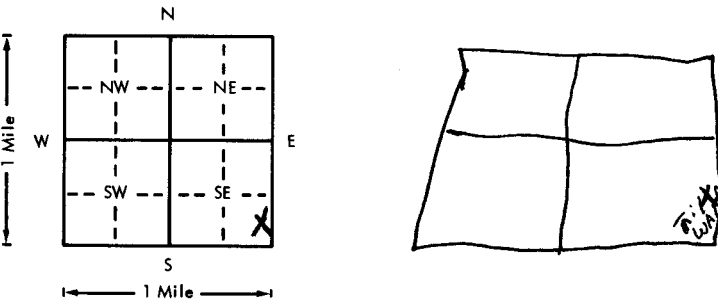


USE TYPEWRITER OR BALL POINT PEN-PRESS FIRMLY, PRINT CLEARLY.

WATER WELL RECORD
KSA 82a-1201-1215

Kansas Department of Health and Environment-Division of Environment
(Water well Contractors)
Topeka, Kansas 66620

1500

| 1. Location of well: County <u>SHERMAN</u> Fraction <u>SE 1/4 SE 1/4 SE 1/4</u> Section number <u>36</u> Township number <u>T 9 S R 41</u> Range number <u>EW</u> | |
|---|
| 2. Distance and direction from nearest town or city: <u>8.51 W of Great Western Supermarket</u> Street address of well location if in city: <u>Great Western Supermarket</u> 3. Owner of well: <u>Dan Dorn</u> R.R. or street: <u>Queeny, Colo.</u> City, state, zip code: <u>Queeny, Colo.</u> | |
| 4. Locate with "X" in section below: Sketch map:  | |
| 5. Type and color of material <u>Topsiol</u> | |
| <table border="1" style="width:100%; border-collapse: collapse;"> <thead> <tr> <th style="width:80%;"></th> <th style="width:10%;">From</th> <th style="width:10%;">To</th> </tr> </thead> <tbody> <tr> <td><u>Clay - Gravel</u></td> <td><u>0</u></td> <td><u>3</u></td> </tr> <tr> <td><u>Gravel</u></td> <td><u>3</u></td> <td><u>154</u></td> </tr> <tr> <td><u>Sandy clay</u></td> <td><u>154</u></td> <td><u>164</u></td> </tr> <tr> <td><u>Gravel</u></td> <td><u>164</u></td> <td><u>201</u></td> </tr> <tr> <td><u>Gravel</u></td> <td><u>201</u></td> <td><u>204</u></td> </tr> <tr> <td><u>Sandstone</u></td> <td><u>204</u></td> <td><u>210</u></td> </tr> <tr> <td><u>Gravel</u></td> <td><u>210</u></td> <td><u>216</u></td> </tr> <tr> <td><u>Sandstone</u></td> <td><u>216</u></td> <td><u>234</u></td> </tr> <tr> <td><u>Gravel</u></td> <td><u>234</u></td> <td><u>236</u></td> </tr> <tr> <td><u>Clay</u></td> <td><u>236</u></td> <td><u>237</u></td> </tr> <tr> <td><u>Gravel</u></td> <td><u>237</u></td> <td><u>246</u></td> </tr> <tr> <td><u>Clay</u></td> <td><u>246</u></td> <td><u>249</u></td> </tr> <tr> <td><u>Gravel</u></td> <td><u>249</u></td> <td><u>259</u></td> </tr> <tr> <td><u>Soapstone</u></td> <td><u>259</u></td> <td><u>275</u></td> </tr> <tr> <td><u>Shale</u></td> <td><u>275</u></td> <td><u>280</u></td> </tr> <tr> <td colspan="3" style="text-align:center;"><u>BROCK 259</u></td> </tr>
| 6. Bore hole dia. <u>16</u> in. Completion date <u>4-29-76</u> Well depth <u>282</u> ft. | |
| 7. Cable tool <input type="checkbox"/> Rotary <input type="checkbox"/> Driven <input type="checkbox"/> Dug <input type="checkbox"/> Hollow rod <input type="checkbox"/> Jetted <input type="checkbox"/> Bored <input checked="" type="checkbox"/> Reverse rotary | |
| 8. Use: Domestic <input type="checkbox"/> Public supply <input type="checkbox"/> Industry <input checked="" type="checkbox"/> Irrigation <input type="checkbox"/> Air conditioning <input type="checkbox"/> Stock <input type="checkbox"/> Lawn <input type="checkbox"/> Oil field water <input type="checkbox"/> Other <input type="checkbox"/> | |
| 9. Casing: Material <u>Steel</u> (Height <u>8</u> or below) Threading <u>Welded</u> <input checked="" type="checkbox"/> Surface <u>8</u> in. RMP <u>PVC</u> Weight <u>37</u> lbs./ft. Dia. <u>16</u> in. to <u>282</u> ft. depth Wall Thickness: inches or Dia. <u>1/8</u> in. to <u>1/8</u> ft. depth gage No. <u>158</u> | |
| 10. Screen: Manufacturer's name <u>W.H. Brown</u> Type <u>Mill soil</u> Dia. <u>16</u> Slot/gauze <u>1/2</u> Length <u>120</u> Set between <u>162</u> ft. and <u>282</u> ft. Gravel pack? <input checked="" type="checkbox"/> Size range of material <u>1/2</u> | |
| 11. Static water level: <u>154</u> ft. below land surface Date <u>4-29-76</u> mo./day/yr. | |
| 12. Pumping level below land surfaces: <u>220</u> ft. after <u>8</u> hrs. pumping <u>600</u> g.p.m. <u>270</u> ft. after <u>16</u> hrs. pumping <u>708</u> g.p.m. Estimated maximum yield <u>708</u> g.p.m. | |
| 13. Water sample submitted: <u>Yes</u> <input checked="" type="checkbox"/> <u>No</u> <input type="checkbox"/> Date _____ mo./day/yr. | |
| 14. Well head completion: Pitless adapter _____ Inches above grade | |
| 15. Well grouted? <input checked="" type="checkbox"/> With: Neat cement <input checked="" type="checkbox"/> Bentonite _____ Concrete _____ Depth: From <u>9</u> ft. to <u>10</u> ft. | |
| 16. Nearest source of possible contamination: ft. _____ Direction _____ Type _____ Well disinfected upon completion? <u>Yes</u> <input type="checkbox"/> <u>No</u> <input checked="" type="checkbox"/> | |
| 17. Pump: Manufacturer's name <u>JAIT A & C</u> No. installed _____ Model number <u>1240C</u> HP _____ Volts _____ Length of drop pipe <u>270</u> ft. capacity <u>708</u> g.p.m. Type: Submersible <input type="checkbox"/> Turbine <input checked="" type="checkbox"/> Jet <input type="checkbox"/> Reciprocating <input type="checkbox"/> Centrifugal <input type="checkbox"/> Other <input type="checkbox"/> | |
| 18. Elevation: _____ 19. Remarks: <u>3795</u> | |
| 20. Water well contractor's certification: This well was drilled under my jurisdiction and this report is true to the best of my knowledge and belief. <u>Forest Supply Co Inc 144</u> Business name _____ (License No. _____) Address <u>Box 338 Goodland</u> Signed <u>Ralph E. Brown</u> Date <u>6-15-76</u> Authorized representative | |

T 9 R 41 EW 36 SE SE SE 1/4 1/4 1/4