


1] LOCATION OF WATER WELL: Fraction: NW 1/4 NW 1/4 NE 1/4 Section Number: 33 Township Number: T 9 S Range Number: R 42 E (NW)
 County: Sherman

Distance and direction from nearest town or city street address of well if located within city?
7 South 1/2 East of Kanorado

2] WATER WELL OWNER: Tom Sillerwells
 RR#, St. Address, Box #: Box 28 Board of Agriculture, Division of Water Resources
 City, State, ZIP Code: Kanorado, KS 67741 Application Number:

3] LOCATE WELL'S LOCATION WITH AN "X" IN SECTION BOX:

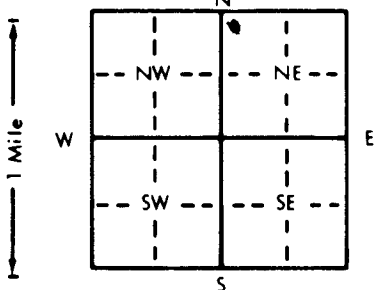

4] DEPTH OF COMPLETED WELL: 270 ft. ELEVATION:
 Depth(s) Groundwater Encountered 1. 150 ft. 2. 150 ft. 3. 150 ft.
 WELL'S STATIC WATER LEVEL: 150 ft. below land surface measured on mo/day/yr

 Bore Hole Diameter: 7 in. to 270 ft., and 270 in. to 270 ft.
 WELL WATER TO BE USED AS:
 1 Domestic 3 Feedlot 6 Oil field water supply 9 Dewatering 12 Other (Specify below)
 2 Irrigation 4 Industrial 7 Lawn and garden only 10 Monitoring well
 Was a chemical/bacteriological sample submitted to Department? Yes X No X; If yes, mo/day/yr sample was submitted
 Water Well Disinfected? Yes X No X

5] TYPE OF BLANK CASING USED:
 1 Steel 3 RMP (SR) 6 Asbestos-Cement 9 Other (specify below)
 2 PVC 4 ABS 7 Fiberglass

Blank casing diameter: 4.5 in. to 250 ft., Dia. 160 lbs./ft. Wall thickness or gauge No. SAR26
 Casing height above land surface: 12 in., weight 160 lbs./ft. Wall thickness or gauge No. SAR26

TYPE OF SCREEN OR PERFORATION MATERIAL:
 1 Steel 3 Stainless steel 5 Fiberglass 8 RMP (SR) 11 Other (specify)
 2 Brass 4 Galvanized steel 6 Concrete tile 9 ABS 12 None used (open hole)

SCREEN OR PERFORATION OPENINGS ARE:
 1 Continuous slot 3 Mill slot 5 Gauzed wrapped 8 Saw cut 11 None (open hole)
 2 Louvered shutter 4 Key punched 6 Wire wrapped 7 Torch cut 9 Drilled holes 10 Other (specify)

SCREEN-PERFORATED INTERVALS:

6] GROUT MATERIAL: 1 Neat cement 2 Cement grout 3 Bentonite 4 Other

What is the nearest source of possible contamination: None in view
 1 Septic tank 4 Lateral lines 7 Pit privy 10 Livestock pens 14 Abandoned water well
 2 Sewer lines 5 Cess pool 8 Sewage lagoon 11 Fuel storage 15 Oil well/Gas well
 3 Watertight sewer lines 6 Seepage pit 9 Feedyard 12 Fertilizer storage 16 Other (specify below)
 13 Insecticide storage

Direction from well? _____ How many feet? _____

FROM	TO	LITHOLOGIC LOG	FROM	TO	PLUGGING INTERVALS
0	40	Clay			
40	140	sand & gravel			
140	200	Sandstone			
200	260	Sand & Sandstone			
260	270	Med. Sand			
	270	Shale			

7] CONTRACTOR'S OR LANDOWNER'S CERTIFICATION: This water well was (1) constructed, (2) reconstructed, or (3) plugged under my jurisdiction and was completed on (mo/day/year) 5-29-98 and this record is true to the best of my knowledge and belief. Kansas Water Well Contractor's License No. 484 This Water Well Record was completed on (mo/day/yr) 5-29-98 under the business name of Schaal Drilling Co. by (signature) Richard Schaal