

WATER WELL PLUGGING RECORD Form WWC-5P

KSA 82a-1212

ID NO.


31694-01

1 LOCATION OF WATER WELL: County: SHERMAN	Fraction SW ¼ Sw ¼ NE ¼ NW ¼	Section Number 14	Township Number 9 T 42 S	Range Number <input type="checkbox"/> E <input checked="" type="checkbox"/> W
--	--	-----------------------------	------------------------------------	--

Street/Rural Address of Well Location; if unknown, distance & direction from nearest town or intersection: If at owner's address, check here FROM INTERSTATE 70 & SHERMAN CO ROAD 3 GO SOUTH 3 1/2 MILES, EAST 2 MILES, SOUTH 1/2 MILE

Global Positioning Systems (GPS) information:
 Latitude: _____ (in decimal degrees)
 Longitude: _____ (in decimal degrees)
 Elevation: _____
 Horizontal Datum: WGS84, NAD83, NAD27
 Collection Method: _____
 GPS unit (Make/Model: _____)
 Digital Map/Photo, Topographic Map, Land Survey
 Est. Accuracy: < 3 m, 3-5 m, 5-15 m, > 15 m

2 WATER WELL OWNER: JACE CHIPPERFIELD
 RR#, St. Address, Box #: 6050 ROAD 8
 City, State ZIP Code: GOODLAND KS 67735-8737

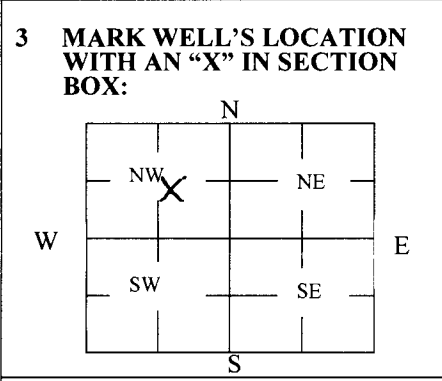

4 DEPTH OF WELL 301 ft.
 WELL'S STATIC WATER LEVEL 211 ft.
 WELL WAS USED AS:
 Domestic Irrigation Irrigation Feedlot Industrial
 Public Water Supply Oil Field Water Supply Domestic (Lawn & Garden) Air Conditioning
 Dewatering Monitoring Injection Well Other _____
 Was a chemical/bacteriological sample submitted to Department? Yes No

5 TYPE OF BLANK CASING USED:
 Steel PVC RMP (SR) ABS Wrought Asbestos-Cement Fiberglass Concrete Tile Other (Specify below) _____
 Blank casing diameter _____ in. Was casing pulled? Yes No If yes, how much _____
 Casing height above or below land surface 36 in.

6 GROUT PLUG MATERIAL: Neat cement Cement grout Bentonite Other _____
 Grout Plug Intervals: From 3 ft. to 6 ft., From _____ ft. to _____ ft., From _____ ft. to _____ ft.
 What is the nearest source of possible contamination:
 Septic tank Sewer lines Watertight sewer lines Lateral lines Cess pool
 Seepage pit Pit privy Sewage lagoon Feedyard Livestock pens
 Fuel storage Fertilizer storage Insecticide storage Abandoned water well Oil well/Gas well
 Other (specify below) _____
 Direction from well? _____
 How many feet? _____

FROM	TO	PLUGGING MATERIALS	FROM	TO	PLUGGING MATERIALS
301	6	WASHED SAND			
6	3	BENTONITE			
3	0	TOP SOIL			

7 CONTRACTOR'S OR LANDOWNER'S CERTIFICATION: This water well was plugged under my jurisdiction and was completed on (mo/day/year) 03-17-2016 and this record is true to the best of my knowledge and belief. Kansas Water Well Contractor's License No. 722. This Water Well Record was completed on (mo/day/year) 04-19-2016 under the business name of WESTERN SPRINKLERS, INC. COLBY, KS by (signature) Paul Niblock **PAUL NIBLOCK**

Send one white copy to Kansas Department of Health & Environment, Geology Section, 1000 SW Jackson Street, Ste. 420, Topeka, KS 66612-1367. Send one copy to WATER WELL OWNER and retain one for your records.
 Visit us at <http://www.kdheks.gov/waterwell/index.html> Telephone 785-296-5524.