

USE TYPEWRITER OR BALL POINT PEN-PRESS FIRMLY, PRINT CLEARLY.


T R EW sec 1/4 1/4 1/4 No.

WATER WELL RECORD  
KSA 82a-1201-1215  
DCO DCO

Kansas State Dept. Of Health  
(Water Well Contractors)  
Forbes-Bldg. 740  
Topeka, Kansas 66620

1 Location of well: County SHERMAN Township name STATE LINE Fraction SW 1/4 SE 1/4 Section number 4 Town number T9S Range number R42W

Distance and direction from nearest town or city: RUKE TON 6 W 3 1/2 W  
Street address of well location if in city: \_\_\_\_\_  
3 Owner of well: DRUINE KIRKEN  
Address: KANORNO KANSAS

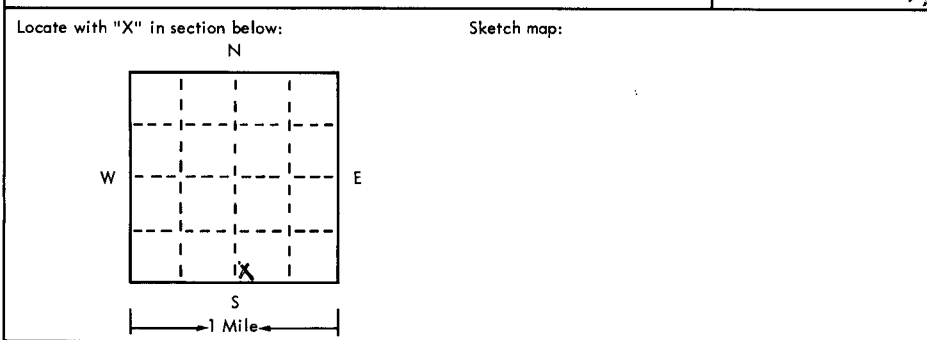

4 Well depth: 264 ft. Date of completion 3-1-75  
Well diameter 8 in.  
5  Cable tool  Rotary  Driven  Dug  
 Hollow rod  Jetted  Bored  Reverse rotary  
6 Use:  Domestic  Public supply  Industry  
 Irrigation  Air conditioning  Commercial  
 Test well  \_\_\_\_\_  
7 Casing: Material Plastic Height: above ~~below~~  
Threaded  Welded  Surface 12 in.  
Diam. \_\_\_\_\_ Weight \_\_\_\_\_ lbs./ft. \_\_\_\_\_  
4 in. to 264 ft. depth Drive shoe?  Yes  No  
in. to \_\_\_\_\_ ft. depth!

2	Type and color of material	From	To
	<u>M GRAVEL, SANDY CLAY, SANDSTONE</u>	<u>136</u>	<u>154</u>
	<u>M GRAVEL</u>	<u>154</u>	<u>157</u>
	<u>M GRAVEL, SANDY CLAY SANDSTONE</u>	<u>157</u>	<u>178</u>
	<u>M GRAVEL, SANDSTONE</u>	<u>178</u>	<u>197</u>
	<u>SANDY CLAY</u>	<u>197</u>	<u>203</u>
	<u>M GRAVEL, TRACIA CLAY</u>	<u>203</u>	<u>217</u>
	<u>SANDY CLAY, SANDSTONE</u>	<u>217</u>	<u>229</u>
	<u>FINE SAND, M GRAVEL</u>	<u>229</u>	<u>238</u>
	<u>SANDSTONE</u>	<u>238</u>	<u>239</u>
	<u>M GRAVEL</u>	<u>239</u>	<u>246</u>
	<u>CLAY</u>	<u>246</u>	<u>248</u>
	<u>M GRAVEL, SANDY CLAY, SANDSTONE</u>	<u>248</u>	<u>257</u>
	<u>M GRAVEL</u>	<u>257</u>	<u>261</u>
	<u>OCHRC</u>	<u>261</u>	<u>266</u>
	(use a second sheet if needed)		

8 Screen:  
Manufacturer JESS & LOWELL  
Type LUGER RMP Dia. 4"  
Slot gauze 10 300 Length 16  
Set between 248 ft. and 264 ft. \_\_\_\_\_  
Fittings:  
Gravel pack  Yes  No Size range of material 1/4  
9 Static water level:  
137 ft. below land surface Date 3-2-75  
10 Pumping level below land surfaces:  
\_\_\_\_\_ ft. after \_\_\_\_\_ hrs. pumping \_\_\_\_\_ g.p.m.  
\_\_\_\_\_ ft. after \_\_\_\_\_ hrs. pumping \_\_\_\_\_ g.p.m.  
Estimated maximum yield 50 g.p.m.  
11 Water sample submitted:  
 Yes  No Date \_\_\_\_\_  
12 Well head completion:  
 Pitless adapter 12"  Inches above grade  
13 Well grouted?  Yes  No  
 Neat cement  Bentonite  \_\_\_\_\_  
Depth: From 5 ft. to 15 ft.  
14 Nearest source of possible contamination:  
ft. \_\_\_\_\_ Direction \_\_\_\_\_ Type None  
Well disinfected upon completion?  Yes  No  
15 Pump:  Not installed  
Manufacturer's name Red Jacket  
Model number 158C HP 1 Volts 220  
Length of drop pipe 168 ft. capacity 15 g.m.p.  
Type:  
 Submersible  Turbine  
 Jet  Reciprocating  
 Centrifugal  Other

16 Remarks: elevation  
Topography:  
 Hill  
 Slope  
 Upland  
 Valley  
3935 (TOPO)  
3933

17 Water well contractor's certification:  
This well was drilled under my jurisdiction and this report is true to the best of my knowledge and belief.  
S & H Drilling Co Inc License No. \_\_\_\_\_  
Business name \_\_\_\_\_  
Address Goodland Kansas  
Signed Bill Clifford Date 3-6-75  
Authorized representative