

USE TYPEWRITER OR BALL POINT PEN-PRESS FIRMLY, PRINT CLEARLY.

Mr. [unclear]


WATER WELL RECORD
KSA 82a-1201-1215

Kansas Department of Health and Environment-Division of Environment
(Water well Contractors)
Topeka, Kansas 66620

CBA

Job #43-77-B-C-29-9-42

1. Location of well:		County Sherman	Fraction NE 1/4 NW 1/4 SW 1/4	Section number 29	Township number T 9 S R	Range number 42
2. Distance and direction from nearest town or city: From Kanorado; 6 1/2 South Street address of well location if in city:				3. Owner of well: Ed Meissinger R.R. or street: City, state, zip code: Kanorado, Kansas		
4. Locate with "X" in section below: N W E S 1 Mile 1 Mile				6. Bore hole dia. <u>36</u> in. Completion date <u>7-19-77</u> Well depth <u>286</u> ft.		
				7. <input type="checkbox"/> Cable tool <input type="checkbox"/> Rotary <input type="checkbox"/> Driven <input type="checkbox"/> Dug <input type="checkbox"/> Hollow rod <input type="checkbox"/> Jetted <input checked="" type="checkbox"/> Bored <input checked="" type="checkbox"/> Reverse rotary		
5. Type and color of material				8. Use: <input type="checkbox"/> Domestic <input type="checkbox"/> Public supply <input type="checkbox"/> Industry <input checked="" type="checkbox"/> Irrigation <input type="checkbox"/> Air conditioning <input type="checkbox"/> Stock <input type="checkbox"/> Lawn <input type="checkbox"/> Oil field water <input type="checkbox"/> Other		
				9. Casing: Material <u>Steel</u> Height: Above or Below Threaded <input type="checkbox"/> Welded <input checked="" type="checkbox"/> Surface <u>12</u> in. RMP <input type="checkbox"/> PVC <input type="checkbox"/> Weight <u>.188</u> lbs./ft. Dia. <u>16</u> in. to <u>176</u> ft. depth Wall Thickness: <u>inches</u> or Dia. <u>in.</u> to <u>ft.</u> depth gauge No. <u>#7</u>		
				10. Screen: Manufacturer's name <u>Brown</u> Type <u>Regular</u> Dia. <u>16"</u> Slot/gauze <u>10%</u> Length <u>100'</u> Set between <u>176</u> ft. and <u>276</u> ft. <u>10' John.</u> <u>276</u> ft. and <u>286</u> ft. Gravel pack? <input checked="" type="checkbox"/> Size range of material <u>50%/150%</u>		
				11. Static water level: <u>135</u> ft. below land surface Date <u>7-21-77</u> mo./day/yr.		
				12. Pumping level below land surfaces: <u>280</u> ft. after <u>2</u> hrs. pumping <u>1086</u> g.p.m. <u>ft.</u> after <u>hrs.</u> pumping <u>g.p.m.</u> Estimated maximum yield <u>1086</u> g.p.m.		
				13. Water sample submitted: <u>Yes</u> <input checked="" type="checkbox"/> <u>No</u> <input type="checkbox"/> Date <u>mo./day/yr.</u>		
				14. Well head completion: <input type="checkbox"/> Pitless adapter <u>12</u> inches above grade		
				15. Well grouted? <input checked="" type="checkbox"/> With: <input type="checkbox"/> Neat cement <input checked="" type="checkbox"/> Bentonite <input checked="" type="checkbox"/> Concrete Depth: From <u>0</u> ft. to <u>10</u> ft.		
				16. Nearest source of possible contamination: ft. <u>374M</u> Direction <u>S=SE</u> Type <u>Farmstead</u> Well disinfected upon completion? <input type="checkbox"/> Yes <input checked="" type="checkbox"/> No		
				17. Pump: Not installed Manufacturer's name <u>Amarillo</u> Model number <u>110784</u> HP <u>100</u> Volts <u>480</u> Length of drop pipe <u>270</u> ft. capacity <u>900</u> g.p.m. Type: <input type="checkbox"/> 5 Stage 12 DOH Bowl <input type="checkbox"/> Submersible <input checked="" type="checkbox"/> Turbine <input type="checkbox"/> Jet <input type="checkbox"/> Reciprocating <input type="checkbox"/> Centrifugal <input type="checkbox"/> Other		
18. Elevation:		19. Remarks:		20. Water well contractor's certification:		
Topography: <input type="checkbox"/> Hill <input type="checkbox"/> Slope <input checked="" type="checkbox"/> Upland <input type="checkbox"/> Valley		<u>3968 (top)</u>		This well was drilled under my jurisdiction and this report is true to the best of my knowledge and belief. WesternWell & Pump 245 Business name Address <u>Box 852, Colby, KS</u> License No. <u>67701</u> Signed <u>Darryl Berry</u> Date <u>8/26/77</u> Authorized representative		

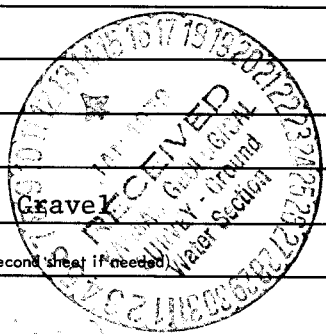

1/2 x 5/8
T-9
R-42
E-29
S-9
NW 1/4 SW 1/4