

MT. SUNFLOWER, NE

USE TYPEWRITER OR BALL POINT PEN-PRESS FIRMLY, PRINT CLEARLY.

T R EW sec 1/4 1/4 1/4 No.

WATER WELL RECORD KSA 82a-1201-1215


Kansas State Dept. Of Health (Water Well Contractors) Forbes-Bldg. 740 Topeka, Kansas 66620

CEA CB3

1 Location of well:	County Sherman	Township name State line	Fraction NE 1/4 NW 1/4 SW 1/4	Section number 29	Town number 9	Range number 42
---------------------	--------------------------	------------------------------------	---	-----------------------------	-------------------------	---------------------------

Distance and direction from nearest town or city: **6 miles south of Kanorado**

3 Owner of well: **Ed Meissinger**
Address: **Kanorado, Kansas**

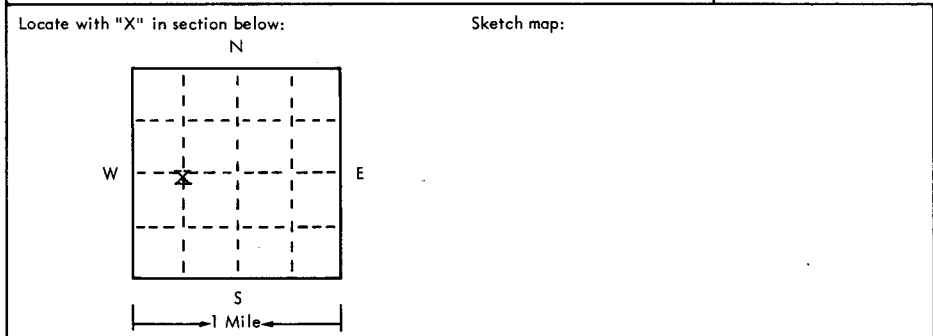

4 Well depth: **279'** ft. Date of completion **2-28-75**
Well diameter **36** in.

5 Cable tool Rotary Driven Dug
 Hollow rod Jetted Bored Reverse rotary

6 Use: Domestic Public supply Industry
 Irrigation Air conditioning Commercial
 Test well

7 Casing: Material **steel** Height: above/below
Threaded Welded Surface **12** in.
Diam. **7 gauge** Weight **7 gauge**
16 in. to **187** ft. depth Drive shoe? Yes No
16 in. to **279** ft. depth **cook**

2	Type and color of material	From	To
	Clay & sand streaks	0	110
	Fine to coarse sand & gravel & few clay lenses	110	152
	Sandy clay - soft	152	163
	Sandy clay & few sand lenses	163	191
	Sandy clay & cemented streaks	191	201
	Fine to coarse sand & few clay streaks	201	236
	Cemented sand	236	238
	Clay	238	250
	Fine to coarse sand & gravel & clay ball	250	267
	Clay	267	275
	Fine to coarse sand & gravel	275	278
	Shale	278	279
	BROOK 198		
	(use a second sheet if needed)		

8 Screen: **W. A. Brown**
Manufacturer: **W. A. Brown**
Type **bridge** Dia. **16**
Slot/gauze **1/8** Length **2"**
Set between **189** ft. and **269** ft.
Fittings:
Gravel pack Yes No Size range of material **1/2 x 5/8**

9 Static water level:
127 ft. below land surface Date **3-1-75**

10 Pumping level below land surfaces:
270 ft. after **2** hrs. pumping **907** g.p.m.
____ ft. after ____ hrs. pumping ____ g.p.m.
Estimated maximum yield **907** g.p.m.

11 Water sample submitted:
 Yes No Date _____

12 Well head completion:
 Pitless adapter **12** Inches above grade

13 Well grouted? Yes No
 Neat cement Bentonite & clay
Depth: From **0** ft. to **10** ft.

14 Nearest source of possible contamination:
ft. **1200** Direction **east** Type **home**
Well disinfected upon completion? Yes No

15 Pump: Not installed
Manufacturer's name **Byron Jackson**
Model number **8** HP **100** Volts _____
Length of drop pipe **270** ft. capacity **907** g.p.m.
Type:
 Submersible Turbine
 Jet Reciprocating
 Centrifugal Other

16 Remarks: elevation

Topography:
 Hill
 Slope
 Upland
 Valley

3973

17 Water well contractor's certification:
This well was drilled under my jurisdiction and this report is true to the best of my knowledge and belief.
Western Well & pump inc. 245
Business name **Western Well & pump inc.**
Address **PO BOX 852, Colby, KS**
Signed **Roy E. Jensen** Date **3-28-75**
Authorized representative