

USE TYPEWRITER OR BALL POINT PEN—PRESS FIRMLY, PRINT CLEARLY.


MT. SARKOWSKI
BBO BAC

WATER WELL RECORD
KSA 82a-1201-1215

Kansas Department of Health and Environment—Division of Environment
(Water well Contractors)
Topeka, Kansas 66620

Job #224-77-B-32-9-42

1. Location of well:		County Sherman	Fraction NW SE 1/4 NW 1/4 SW 1/4	Section number 32	Township number T 9 S R 42	Range number 42
2. Distance and direction from nearest town or city: From Kanorado, 7 South Street address of well location if in city:			3. Owner of well: Dale, Cloyd R.R. or street: City, state, zip code: Kanorado, Kansas			
4. Locate with "X" in section below: N W E S 1 Mile			Sketch map: 		6. Bore hole dia. 30 in. Completion date 7-20-77 Well depth 284 ft.	
5. Type and color of material			From		To	
Sandy Clay			0		35	
Gravel			35		45	
Sandstone Firm			45		70	
Coarse Sand, Gravel			70		79	
Sandstone, Clay, Hard Clay			79		95	
Coarse Sand, Gravel			95		110	
Clay, Sandstone Firm			110		148	
Coarse Sand, Gravel			148		152	
Cemented Clay			152		157	
Coarse Sand, Gravel			157		160	
Cemented Clay			160		210	
Fine to Med. Sand			210		238	
Clay			238		243	
Fine to Med. Sand			243		254	
Clay			254		257	
Fine to Med. Sand			257		261	
Hard Clay			261		262	
Coarse Sand, Gravel			262		282	
Ochre, Shale			282		284	
Continued on record sheet (Use a second sheet if needed)						
18. Elevation: Topography: ___ Hill ___ Slope <input checked="" type="checkbox"/> Upland ___ Valley		19. Remarks: TD = 290 ft 375 (TOPO)		20. Water well contractor's certification: This well was drilled under my jurisdiction and this report is true to the best of my knowledge and belief. Western Well & Pump 245 Business name Address Box 852, Colby, KS License No. 67701 Signed Dolly Berry Date 8/29/77 Authorized representative		

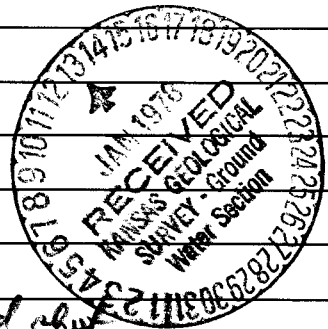

T 9 R 42 S R 42 SE NW NW 1/4 1/4 1/4