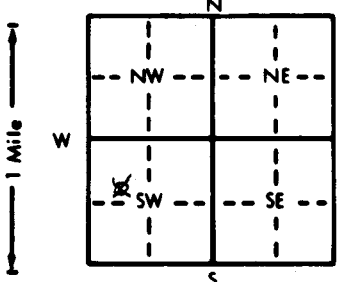


WATER WELL RECORD Form WWC-5 KSA 82a-1212

1 LOCATION OF WATER WELL: County: <b>SHERMAN</b>	Fraction <b>SE 1/4 NW 1/4 SW 1/4</b>	Section Number <b>36</b>	Township Number <b>T 9 S</b>	Range Number <b>R 42 EW</b>
---	---	-----------------------------	---------------------------------	--------------------------------

Distance and direction from nearest town or city street address of well if located within city?  
**N/A LOCATION CONFIRMED BY GWD #4**

2 WATER WELL OWNER: RR#, St. Address, Box # : <b>MARGARET, GENNIFER RICHARD GOLDEN</b> City, State, ZIP Code : <b>BOX 330</b> <b>GOODLAND KS 67735</b>	Board of Agriculture, Division of Water Resources Application Number:
---	--

3 LOCATE WELL'S LOCATION WITH AN "X" IN SECTION BOX: 	4 DEPTH OF COMPLETED WELL..... ft. ELEVATION: ..... ft. Depth(s) Groundwater Encountered 1..... ft. 2..... ft. 3..... ft. WELL'S STATIC WATER LEVEL ..... ft. below land surface measured on mo/day/yr ..... ft. Pump test data: Well water was ..... ft. after ..... hours pumping ..... gpm Est. Yield ..... gpm; Well water was ..... ft. after ..... hours pumping ..... gpm Bore Hole Diameter ..... in. to ..... ft., and ..... in. to ..... ft. WELL WATER TO BE USED AS: 5 Public water supply 8 Air conditioning 11 Injection well <input checked="" type="checkbox"/> Domestic 3 Feedlot 6 Oil field water supply 9 Dewatering 12 Other (Specify below) 2 Irrigation 4 Industrial 7 Lawn and garden only 10 Monitoring well Was a chemical/bacteriological sample submitted to Department? Yes.....No.....; If yes, mo/day/yr sample was submitted Water Well Disinfected? Yes No
--	---

5 TYPE OF BLANK CASING USED: <input checked="" type="checkbox"/> 1 Steel 3 RMP (SR) 5 Wrought iron 8 Concrete tile CASING JOINTS: Glued ..... Clamped ..... 2 PVC 4 ABS 6 Asbestos-Cement 9 Other (specify below) Welded ..... Blank casing diameter ..... in. to ..... ft., Dia ..... in. to ..... ft., Dia ..... in. to ..... ft. Casing height above land surface ..... in., weight ..... lbs./ft. Wall thickness or gauge No. .... TYPE OF SCREEN OR PERFORATION MATERIAL: 7 PVC 10 Asbestos-cement 1 Steel 3 Stainless steel 5 Fiberglass 8 RMP (SR) 11 Other (specify) ..... 2 Brass 4 Galvanized steel 6 Concrete tile 9 ABS 12 None used (open hole) SCREEN OR PERFORATION OPENINGS ARE: 5 Gauzed wrapped 8 Saw cut 11 None (open hole) 1 Continuous slot 3 Mill slot 6 Wire wrapped 9 Drilled holes 2 Louvered shutter 4 Key punched 7 Torch cut 10 Other (specify) .....
SCREEN-PERFORATED INTERVALS: From ..... ft. to ..... ft., From ..... ft. to ..... ft. GRAVEL PACK INTERVALS: From ..... ft. to ..... ft., From ..... ft. to ..... ft. From ..... ft. to ..... ft., From ..... ft. to ..... ft.

6 GROUT MATERIAL: 1 Neat cement 2 Cement grout 3 Bentonite 4 Other .....
Grout intervals: From ..... ft. to ..... ft., From ..... ft. to ..... ft., From ..... ft. to ..... ft.
What is the nearest source of possible contamination: 1 Septic tank 4 Lateral lines 7 Pit privy 10 Livestock pens 14 Abandoned water well 2 Sewer lines 5 Cess pool 8 Sewage lagoon 11 Fuel storage 15 Oil well/Gas well 3 Watertight sewer lines 6 Seepage pit 9 Feedyard 12 Fertilizer storage 16 Other (specify below) 13 Insecticide storage Direction from well? How many feet?

FROM	TO	LITHOLOGIC LOG	FROM	TO	PLUGGING INTERVALS
			bottom	5'	fill sand
			5'	3'	bentonite (poured on outside of casing)
					top of ground fill dirt

**RECEIVED**

APR 02 1998

DIVISION OF ENVIRONMENT

7 CONTRACTOR'S OR LANDOWNER'S CERTIFICATION: This water well was (1) constructed, (2) reconstructed, or (3) plugged under my jurisdiction and was completed on (mo/day/year) ..... <b>12-89</b> ..... and this record is true to the best of my knowledge and belief. Kansas Water Well Contractor's License No. .... This Water Well Record was completed on (mo/day/yr) ..... under the business name of <b>B's Pump &amp; Well Serv.</b> by (signature) <b>Rex Smith</b>
--

OFFICE USE ONLY  
T  
R  
EW  
SEC.  
1/4  
1/4  
1/4