

USE TYPEWRITER OR BALL POINT PEN-PRESS FIRMLY, PRINT CLEARLY.


WATER WELL RECORD
KSA 82a-1201-1215

Kansas Department of Health and Environment-Division of Environment
(Water well Contractors)
Topeka, Kansas 66620

DAD

1. Location of well: County **Sherman** Fraction **SE 1/4 NE 1/4 SE 1/4** Section number **36** Township number **T 9 S R 42** *NW*

2. Distance and direction from nearest town or city: **Kanorado, KS**
Street address of well location if in city: **7 3/4 S ; 3/4 E**
3. Owner of well: **Bob Irwin**
R.R. or street: **North Main**
City, state, zip code: **Goodland, KS 67735**

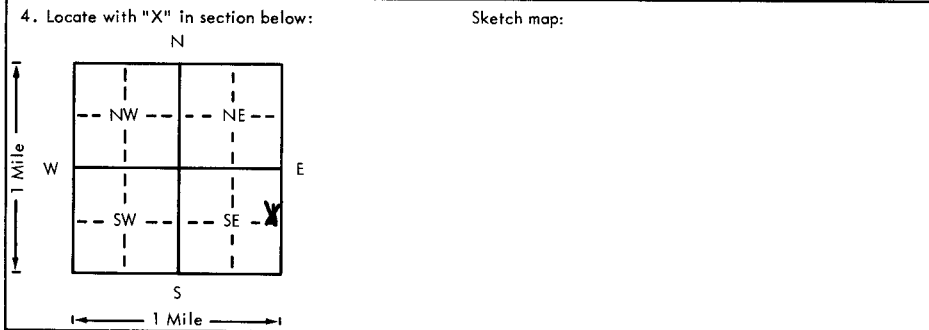

6. Bore hole dia. **36** in. Completion date **8-2-79**
Well depth **282** ft.
7. Cable tool Rotary Driven Dug
 Hollow rod Jetted Bored Reverse rotary
8. Use: Domestic Public supply Industry
 Irrigation Air conditioning Stock
 Lawn Oil field water Other
9. Casing: Material **Steel** Height: Above or below
Threaded Welded Surface **12** in.
RMP PVC Weight **31.75** lbs./ft.
Dia. **16** in. to **282** ft. depth Wall Thickness: inches or
Dia. in. to ft. depth gage No. **.188**

5. Type and color of material	From	To
Clay	0	37
Sand & Gravel	37	44
Clay & Sandstone Streaks	44	56
Sand & Gravel - Clay Streaks	56	112
Sandy Clay	112	132
Coarse Sand & Gravel	132	153
Sandy Clay & Cemented Sand	153	208
Fine Sand & Sandstone Streaks	208	221
Fine to Coarse Sand	221	233
Sandstone - Very Hard	233	236
Clay	236	243
Medium Coarse Sand - Brown	243	261
Clay	261	265
Coarse Sand & Gravel	265	280
Shale	280	282

10. Screen: Manufacturer's name **Cook**
Type **Wire Wrapped** Dia. **16"**
Slot/gauze **100** Length **10**
Set between **272** ft. and **282** ft.
BrownPerf 212 ft. and **272** ft.
Gravel pack? Size range of material **50#1-50#4x5/8**
11. Static water level: **Fine**
167 ft. below land surface Date **8-3-79**
12. Pumping level below land surfaces:
275 ft. after **2** hrs. pumping **1034** g.p.m.
202 ft. after **1** hrs. pumping **699** g.p.m.
Estimated maximum yield **1034** g.p.m.
13. Water sample submitted: Yes No Date _____
14. Well head completion: **12** inches above grade
 Pitless adapter
15. Well grouted?
With: Neat cement Bentonite Concrete
Depth: From **0** ft. to **10** ft.
16. Nearest source of possible contamination:
ft. **3300** Direction **North** Type **Farmstead**
Well disinfected upon completion? Yes No
17. Pump: Not installed
Manufacturer's name **Byron Jackson**
Model number **10MOH** HP **94** Volts _____
Length of drop pipe **280** ft. capacity _____ g.p.m.
Type: Submersible Turbine
 Jet Reciprocating
 Centrifugal Other

18. Elevation: _____
Topography: Hill Slope Upland Valley
19. Remarks: **BROCK 280**
Verbal Approved - Dave Polk 8-2-79

20. Water well contractor's certification:
This well was drilled under my jurisdiction and this report is true to the best of my knowledge and belief.
Western Well & Pump, Inc. 245
Business name License No. _____
Address **Box 852, Colby, KS 67701**
Signed **Dave Polk** Date **8-4-79**
Authorized Representative

-9-42036 SE NE SE
1/4 1/4 1/4
Sec