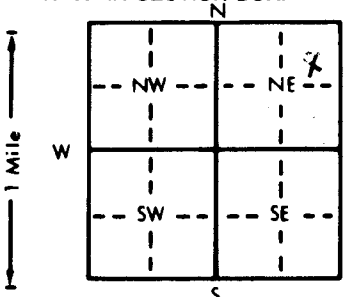


1 LOCATION OF WATER WELL: Fraction  $\frac{1}{4}$  NE  $\frac{1}{4}$  NE  $\frac{1}{4}$  Section Number 14 Township Number T 9 S Range Number R 5 E/W  
 County: OTTAWA  
 Distance and direction from nearest town or city street address of well if located within city?

2 WATER WELL OWNER: Pike Cattle Lot  
 RR#, St. Address, Box # : Dana Hauck Board of Agriculture, Division of Water Resources  
 City, State, ZIP Code : Delphos, Kansas 67436 Application Number:

3 LOCATE WELL'S LOCATION WITH AN "X" IN SECTION BOX:  DEPTH OF COMPLETED WELL: 9.5 ft. ELEVATION: Unknown  
 Depth(s) Groundwater Encountered 1. 34 ft. 2. ft. 3. ft.  
 WELL'S STATIC WATER LEVEL: 3.4 ft. below land surface measured on mo/day/yr 8-26-91  
 Pump test data: Well water was ft. after hours pumping gpm  
 Est. Yield 1.5 gpm: Well water was ft. after hours pumping gpm  
 Bore Hole Diameter: 1.0 in. to 9.5 in. and in. to ft.  
 WELL WATER TO BE USED AS: 5 Public water supply 8 Air conditioning 11 Injection well  
 1 Domestic 3 Feedlot 6 Oil field water supply 9 Dewatering 12 Other (Specify below)  
 2 Irrigation 4 Industrial 7 Lawn and garden only 10 Monitoring well  
 Was a chemical/bacteriological sample submitted to Department? Yes No; If yes, mo/day/yr sample was submitted  
 Water Well Disinfected? Yes X No

5 TYPE OF BLANK CASING USED: 5 Wrought iron 8 Concrete tile CASING JOINTS: Glued X Clamped  
 1 Steel 3 RMP (SR) 6 Asbestos-Cement 9 Other (specify below) Welded  
 2 PVC 4 ABS 7 Fiberglass Threaded  
 Blank casing diameter 5 in. to 25 ft., Dia in. to ft., Dia in. to ft.  
 Casing height above land surface 12 in., weight CLASS 200 lbs./ft. Wall thickness or gauge No.  
 TYPE OF SCREEN OR PERFORATION MATERIAL: 7 PVC 10 Asbestos-cement  
 1 Steel 3 Stainless steel 5 Fiberglass 8 RMP (SR) 11 Other (specify)  
 2 Brass 4 Galvanized steel 6 Concrete tile 9 ABS 12 None used (open hole)  
 SCREEN OR PERFORATION OPENINGS ARE: 5 Gauzed wrapped 8 Saw cut 11 None (open hole)  
 1 Continuous slot 3 Mill slot 6 Wire wrapped 9 Drilled holes  
 2 Louvered shutter 4 Key punched 7 Torch cut 10 Other (specify)  
 SCREEN-PERFORATED INTERVALS: From 25 ft. to 95' ft., From ft. to ft.  
 From ft. to ft., From ft. to ft.  
 GRAVEL PACK INTERVALS: From 65 ft. to 95' ft., From ft. to ft.  
 From ft. to ft., From ft. to ft.

6 GROUT MATERIAL: 1 Neat cement 2 Cement grout 3 Bentonite 4 Other  
 Grout Intervals: From 0 ft. to 20 ft., From ft. to ft., From ft. to ft.  
 What is the nearest source of possible contamination: 10 Livestock pens 14 Abandoned water well  
 1 Septic tank 4 Lateral lines 7 Pit privy 11 Fuel storage 15 Oil well/Gas well  
 2 Sewer lines 5 Cess pool 8 Sewage lagoon 12 Fertilizer storage 16 Other (specify below)  
 3 Watertight sewer lines 6 Seepage pit 9 Feedyard 13 Insecticide storage  
 Direction from well? How many feet? 200

FROM	TO	LITHOLOGIC LOG	FROM	TO	PLUGGING INTERVALS
0	5	Top soil			
5	10	Tan clay			
10	20	Red clay			
20	30	Red, Yellow, White clay			
30	35	Gray clay			
35	45	Gray, Red clay			
45	85	Gray clay			
85	95	Sandstone			
95	96	Rock, Hard			

7 CONTRACTOR'S OR LANDOWNER'S CERTIFICATION: This water well was (1) constructed (2) reconstructed, or (3) plugged under my jurisdiction and was completed on (mo/day/year) 8-26-91 and this record is true to the best of my knowledge and belief. Kansas Water Well Contractor's License No. 480 This Water Well Record was completed on (mo/day/yr) 9/20/91 under the business name of Williams Drilling Co. Inc. by (signature) Ron Williams

OFFICE USE ONLY