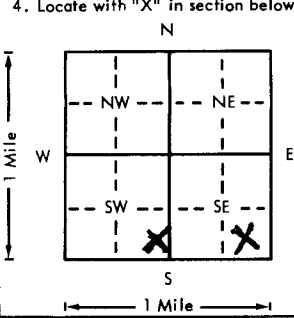


USE TYPEWRITER OR BALL POINT PEN-PRESS FIRMLY, PRINT CLEARLY.

WATER WELL RECORD
KSA 82a-1201-1215

Kansas Department of Health and Environment-Division of Environment
(Water well Contractors)
Topeka, Kansas 66620

1. Location of well:	County Ottawa	Fraction SE 1/4 SW 1/4 SW 1/4	Section number 1998	Township number T 9 S R 5 E/W	
2. Distance and direction from nearest town or city: 9 miles west of DePue & 2 South			3. Owner of well: Tom Shaffer. R.R. or street: RR 2 City, state, zip code: Beloit, Kansas 67420		
4. Locate with "X" in section below: 			Sketch map:		
5. Type and color of material			From	To	6. Bore hole dia. 9 1/2 in. Completion date Aug. 14, 1986 Well depth 96 ft.
Black soil			0	10	7. <input checked="" type="checkbox"/> Cable tool <input checked="" type="checkbox"/> Rotary <input type="checkbox"/> Driven <input type="checkbox"/> Dug <input type="checkbox"/> Hollow rod <input type="checkbox"/> Jetted <input type="checkbox"/> Bored <input type="checkbox"/> Reverse rotary
Creek gravel			10	20	8. Use: <input checked="" type="checkbox"/> Domestic <input type="checkbox"/> Public supply <input type="checkbox"/> Industry <input type="checkbox"/> Irrigation <input type="checkbox"/> Air conditioning <input type="checkbox"/> Stock <input type="checkbox"/> Lawn <input type="checkbox"/> Oil field water <input type="checkbox"/> Other
Grey CLAY			21	40	9. Casing: Material _____ Height: Above or below Threaded _____ Welded _____ Surface _____ in. RMP _____ PVC <input checked="" type="checkbox"/> Weight _____ lbs./ft. Dia. 5" in. to 9 1/2 ft. depth Wall thickness _____ inches or Dia. _____ in. to _____ ft. depth gage No. 14
Sand Stone			40	96	10. Screen: Manufacturer's name Jetstream Type 160 Dia. 5" Slot/gauze 3/32 Length 13 ft Set between 83 ft. and 96 ft. ft. and _____ ft. Gravel pack? <input checked="" type="checkbox"/> Size range of material 1/8
					11. Static water level: _____ mo./day/yr. 40 ft. below land surface Date _____
					12. Pumping level below land surfaces: 50 ft. after 1 hrs. pumping 6 g.p.m. _____ ft. after _____ hrs. pumping _____ g.p.m. Estimated maximum yield 10 g.p.m.
					13. Water sample submitted: _____ mo./day/yr. <input checked="" type="checkbox"/> Yes <input type="checkbox"/> No Date Aug 15 86
					14. Well head completion: NO Pitless adapter 12 inches above grade
					15. Well grouted? <input checked="" type="checkbox"/> With: <input checked="" type="checkbox"/> Neat cement <input type="checkbox"/> Bentonite <input checked="" type="checkbox"/> Concrete Depth: From 0 ft. to 10 ft.
					16. Nearest source of possible contamination ft. 200 Direction West Type Creek Well disinfected upon completion? <input checked="" type="checkbox"/> Yes <input type="checkbox"/> No
					17. Pump: _____ Not installed Manufacturer's name _____ Model number _____ HP _____ Volts _____ Length of drop pipe _____ ft. capacity _____ g.p.m. Type: <input type="checkbox"/> Submersible <input type="checkbox"/> Turbine <input type="checkbox"/> Jet <input type="checkbox"/> Reciprocating <input type="checkbox"/> Centrifugal Cylinder type
18. Elevation: 1570?			19. Remarks: Well to be used for watering cattle in pasture.		
Topography: <input checked="" type="checkbox"/> Hill <input type="checkbox"/> Slope <input type="checkbox"/> Upland <input type="checkbox"/> Valley			20. Water well contractor's certification: This well was drilled under my jurisdiction and this report is true to the best of my knowledge and belief. CARL THOMAN & SON 247 Business name _____ License No. _____ Address 333 E 16th, Concordia, Mo Signature William Thoman Date 8-28-86 Authorized representative		

Forward the white, blue and pink copies to the Department of Health and Environment

Form WWC-5