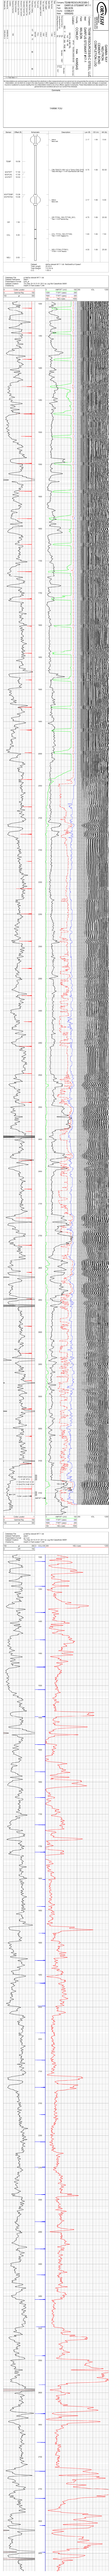

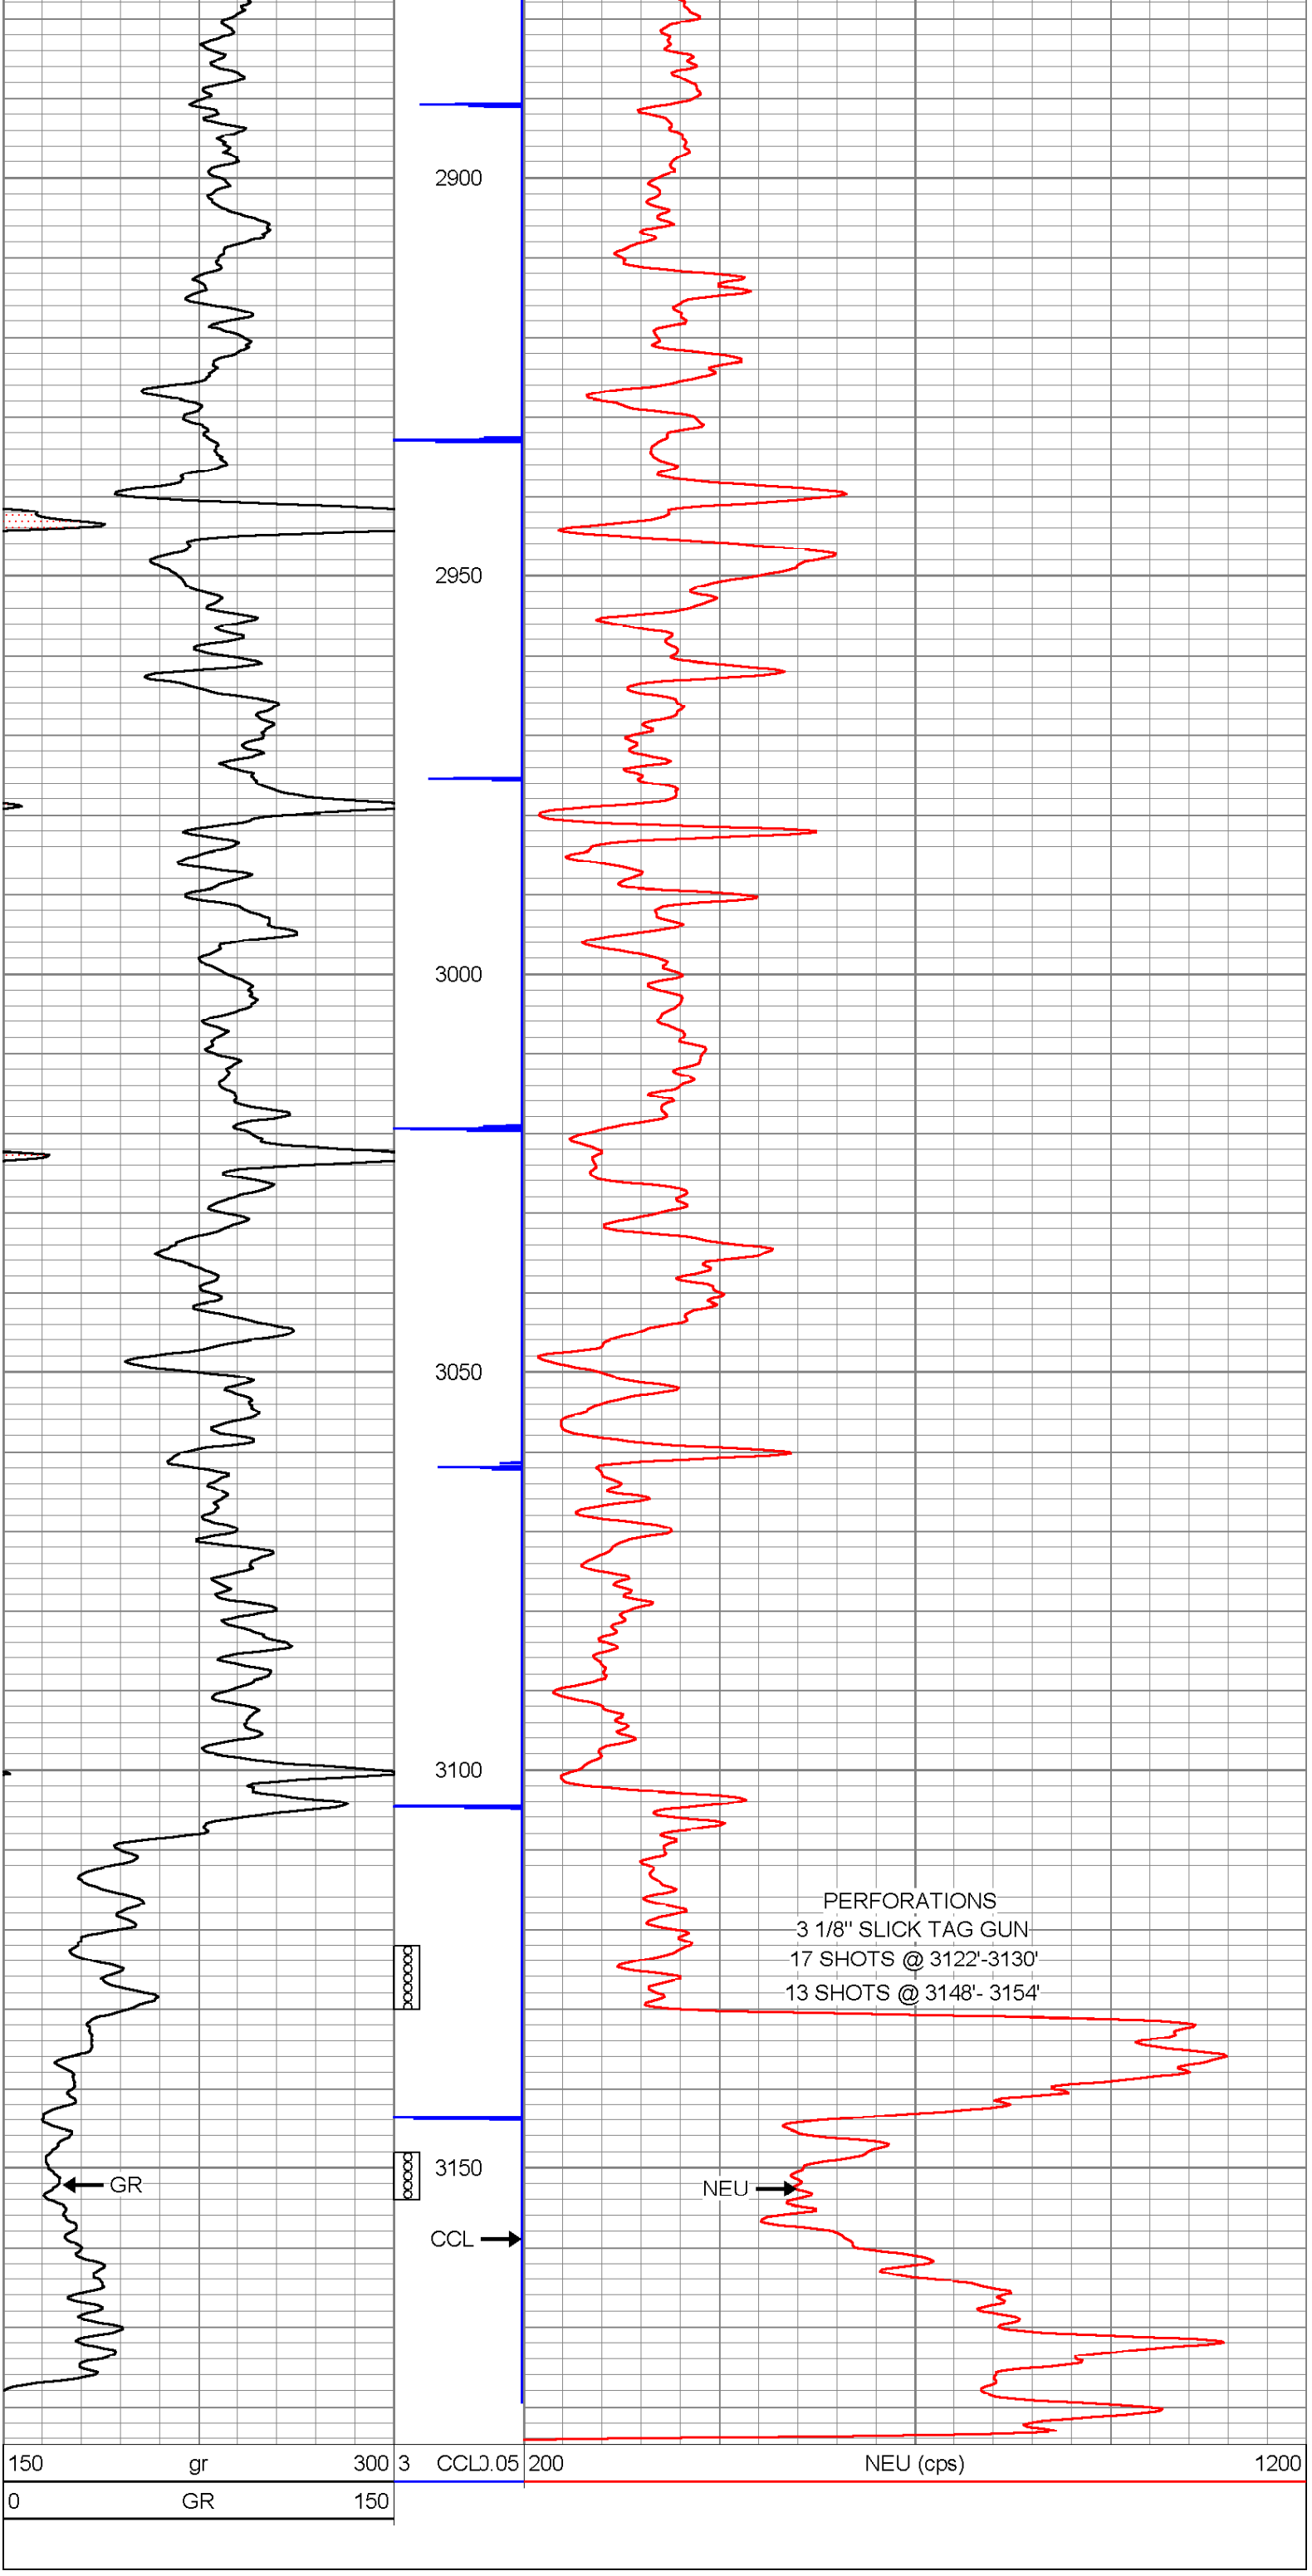

CORNISH WIRELINE SERVICES, INC.
CHANUTE, KANSAS

Company	TEAM RESOURCES/B-C STEEL, LLC
Well	DARFUS STEWART #17-1
Field	WILSON
County	COWLEY SEC. 17 TWP. 33S RGE. 6E
State	KANSAS Date 9-29-11