



NABORS

**COMPLETION
& PRODUCTION
SERVICES CO.**

COMPENSATED DENSITY / NEUTRON LOG

Company PHILLIPS EXPLORATION CO., L.C. Well GAITHER #1-21 Field WILDCAT County TREGO State KANSAS		Company PHILLIPS EXPLORATION COMPANY, L.C. Well GAITHER #1-21 Field WILDCAT County TREGO State KANSAS	
Location: 1980' FNL & 660' FEL SEC 21 TWP 14S RGE 24W Permanent Datum GROUND LEVEL Elevation 2321 Log Measured From KELLY BUSHING 5' A.G.L. Drilling Measured From KELLY BUSHING		Other Services DIL/MEL Elevation K.B. 2326 D.F. 2324 G.L. 2321	
Date	9/24/13		
Run Number	ONE		
Depth Driller	4300		
Depth Logger	4296		
Bottom Logged Interval	4272		
Top Log Interval	3300		
Casing Driller	8 5/8"@218'		
Casing Logger	218		
Bit Size	7 7/8"		
Type Fluid in Hole	CHEMICAL MUD	CHLORIDES 1,400 PPM	
Density / Viscosity	9.4/53		
pH / Fluid Loss	10.5/6.4		
Source of Sample	FLOWLINE		
Rim @ Meas. Temp	.950@80F		
Rmf @ Meas. Temp	.713@80F		
Rmc @ Meas. Temp	1.14@80F		
Source of Rmf / Rmc	MEASUREMENT		
Rim @ BHT	.639@119F		
Time Circulation Stopped	2 HOURS		
Time Logger on Bottom	4:45 P.M.		
Maximum Recorded Temperature	119F		
Equipment Number	4854		
Location	HAYS, KANSAS		
Recorded By	JEFF LUEBBERS		
Witnessed By	PAT DEENIHAN		

<<< Fold Here >>>

All interpretations are opinions based on inferences from electrical or other measurements and we cannot and do not guarantee the accuracy or correctness of any interpretation, and we shall not, except in the case of gross or willful negligence on our part, be liable or responsible for any loss, costs, damages, or expenses incurred or sustained by anyone resulting from any interpretation made by any of our officers, agents or employees. These interpretations are also subject to our general terms and conditions set out in our current Price Schedule.

Comments

THANK YOU FOR USING "NABORS" HAYS, KANSAS (785) 628-6395
 DIRECTIONS
 WAKEENEY, KS. & I-70, 13S. ON HWY 283 TO "RD. V", 5W. TO "200 AVE.", 1/2S., W. INTO



NABORS
 COMPLETION
 & PRODUCTION

MAIN SECTION

Database File:

011675ddn.db

Dataset Pathname:

pass3.4

Presentation Format:

den_neu


Dataset Creation:


Tue Sep 24 18:04:13 2013 by Calc SOC 120430

Charted by:

Depth in Feet scaled 1:240

0	GAMMA RAY (GAPI)	150	ABHV	30	COMPENSATED DENSITY (pu)	-10
6	CALIPER (in)	16	10 (ft3)	0 30	COMPENSATED NEUTRON (pu)	-10
0	MINMK	20	TBHV		-0.25 CORRECTION (g/cc)	0.25
			0 (ft3)	10		

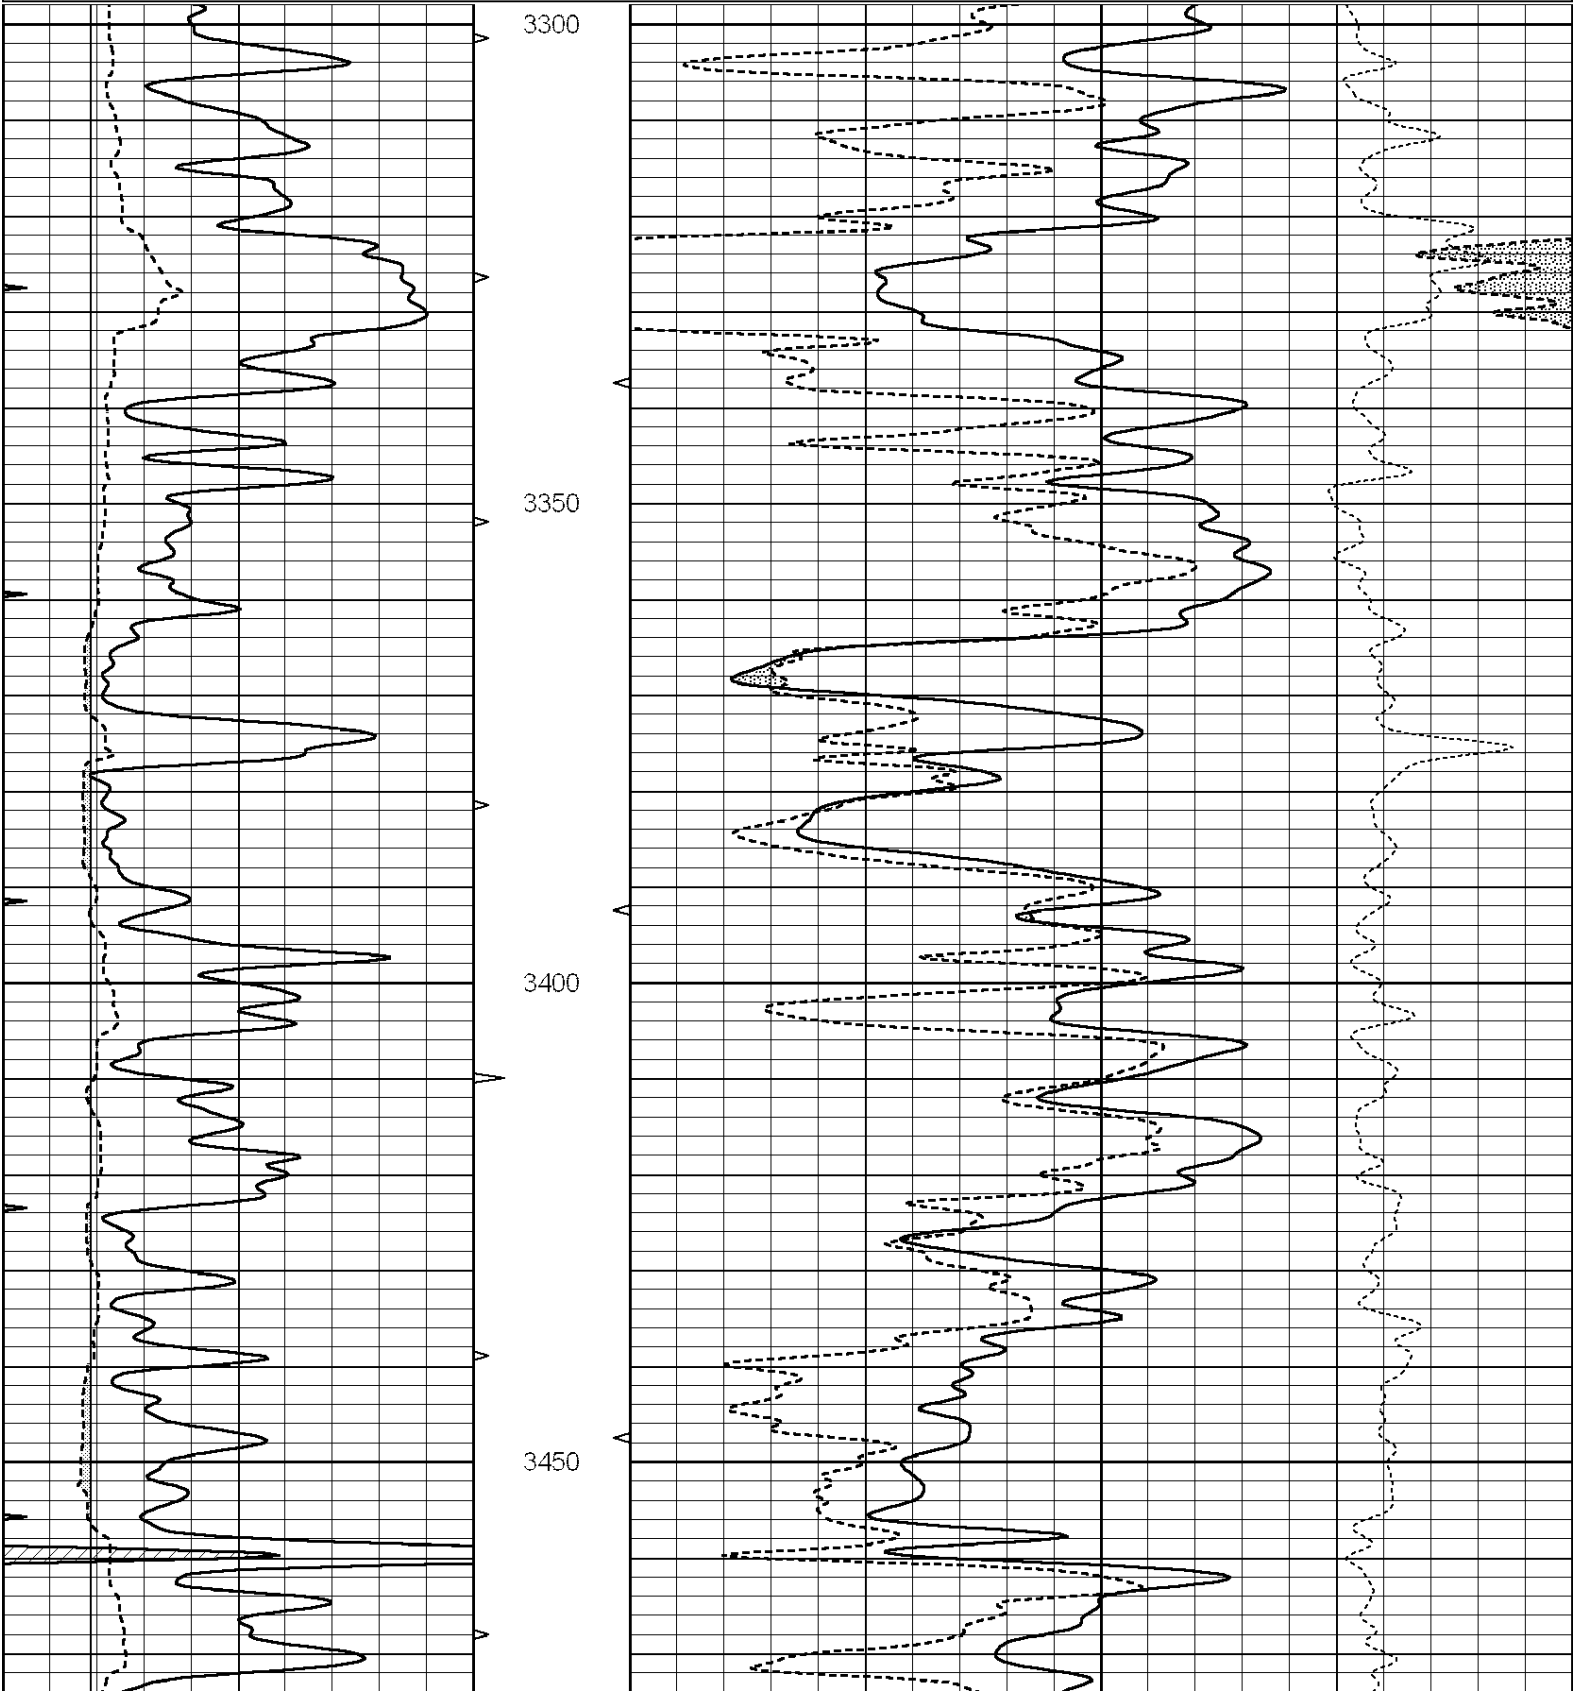


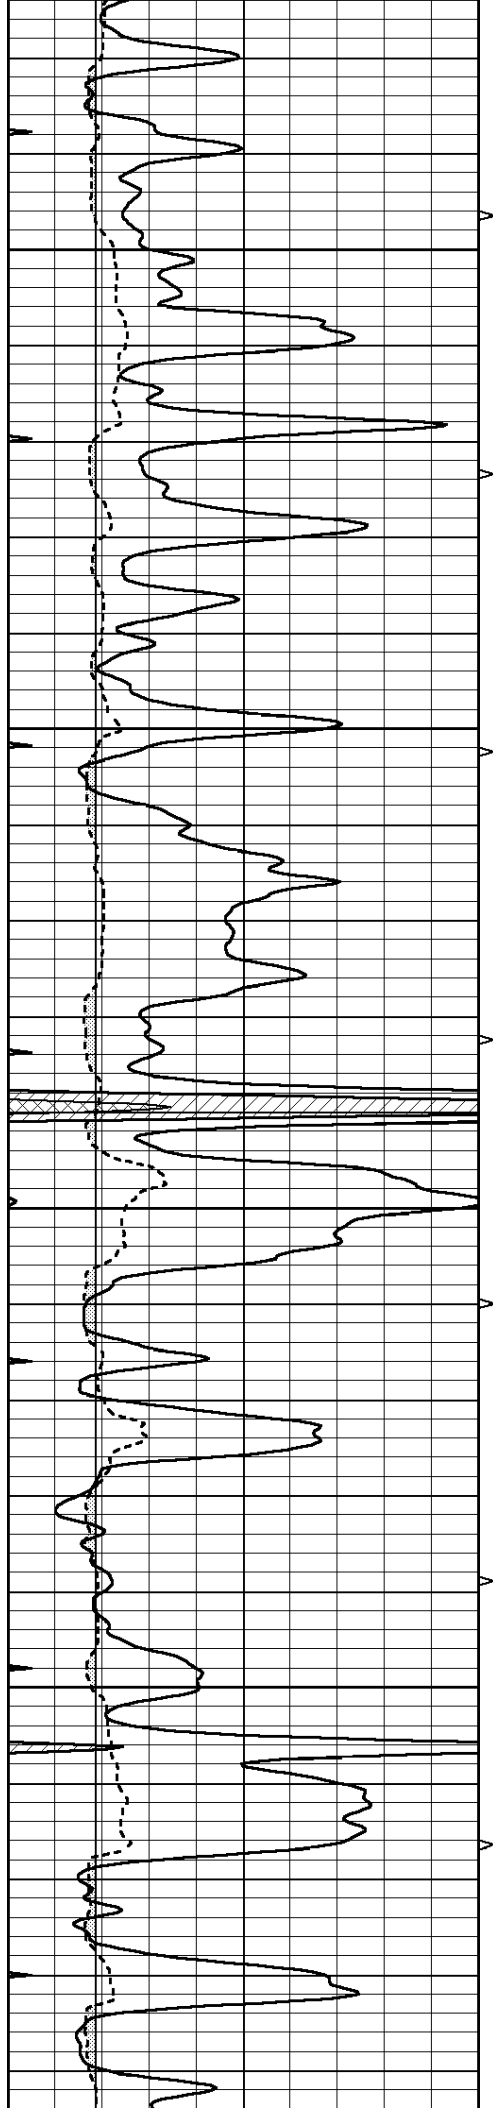




3500


3550

3600

3650

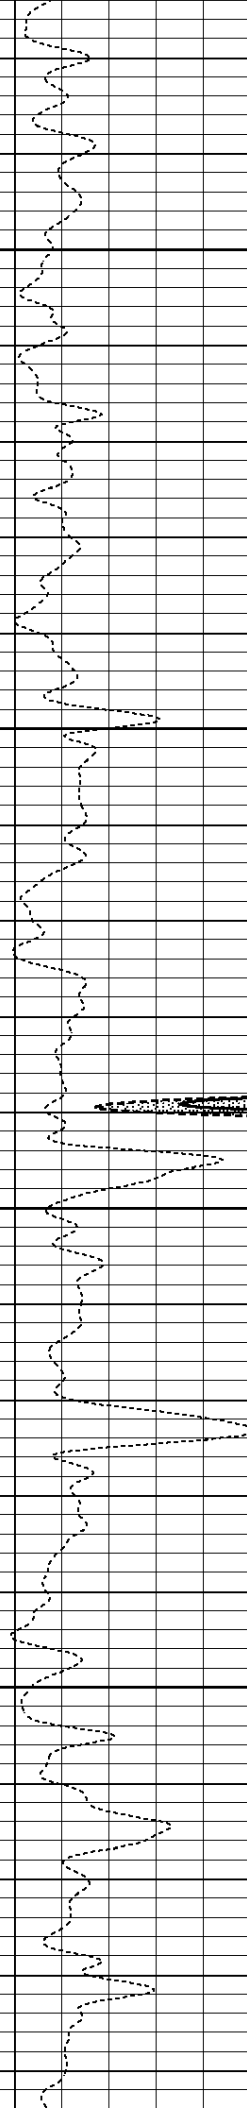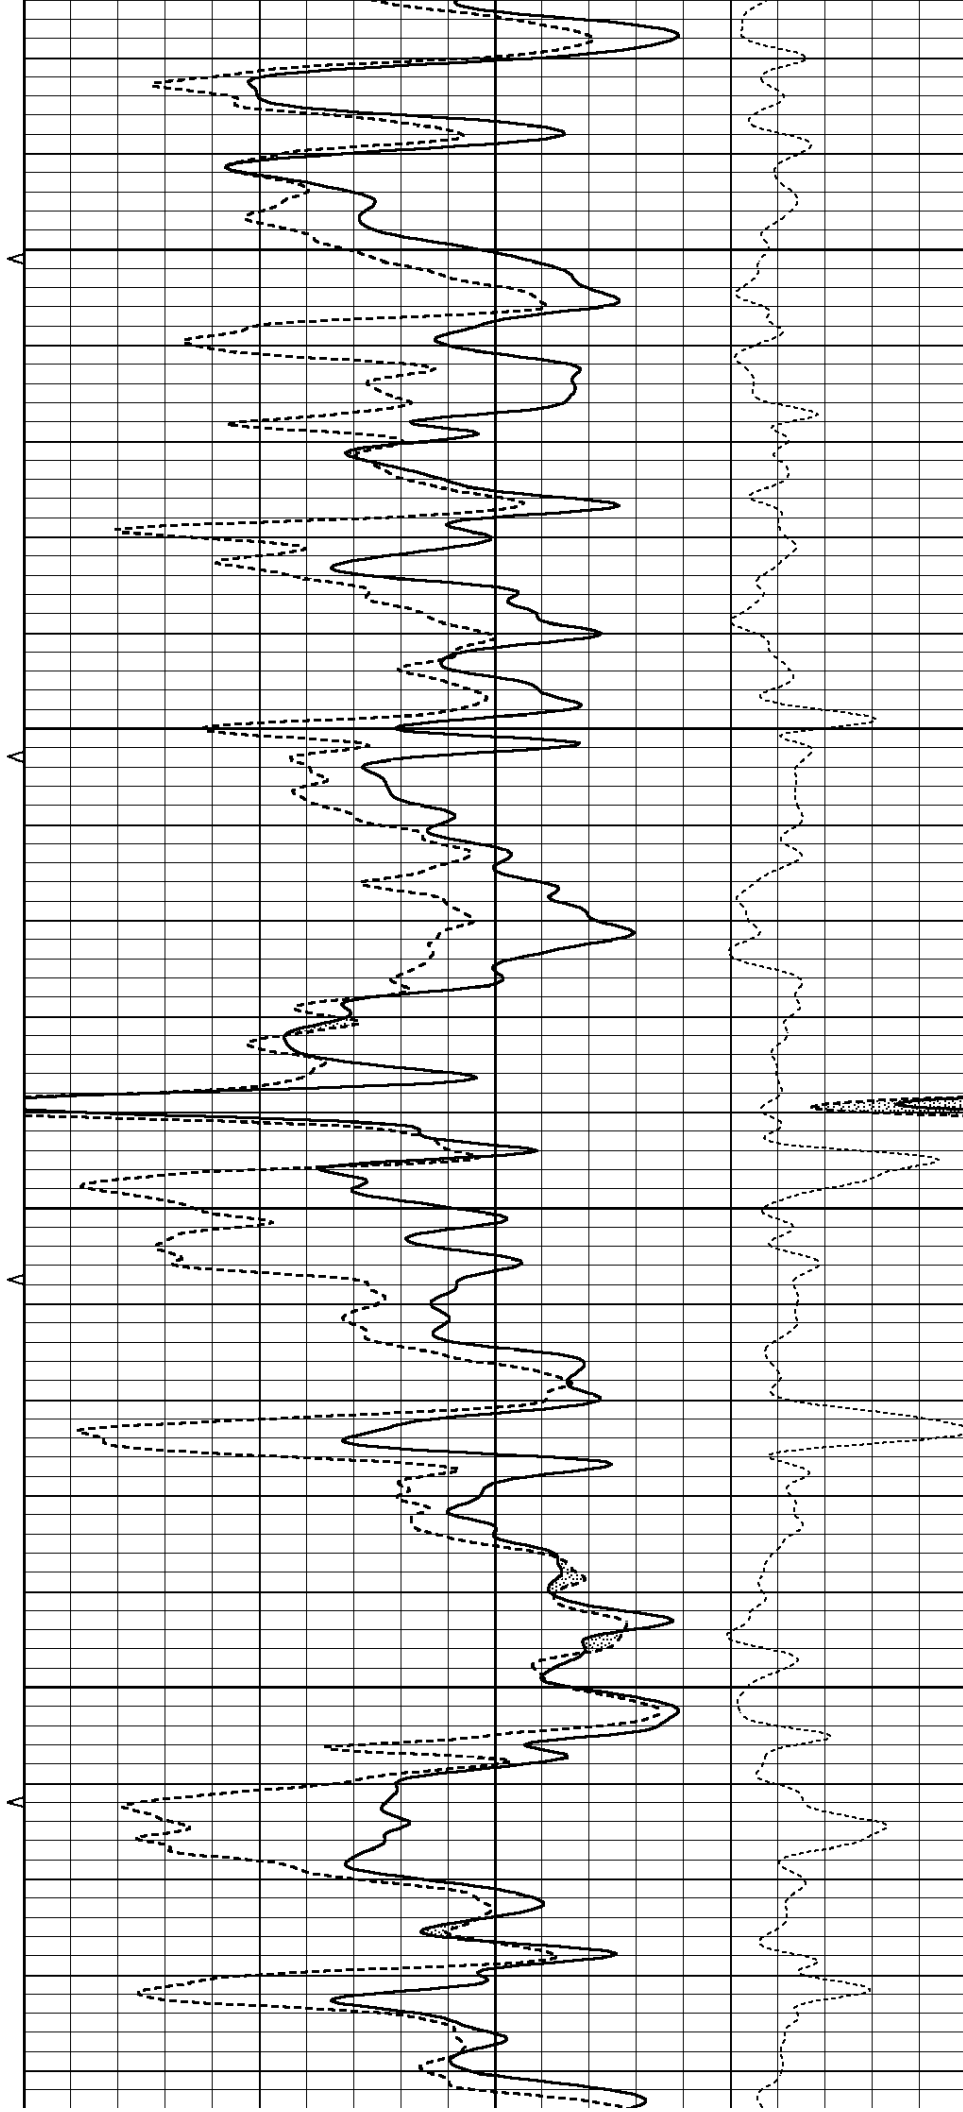

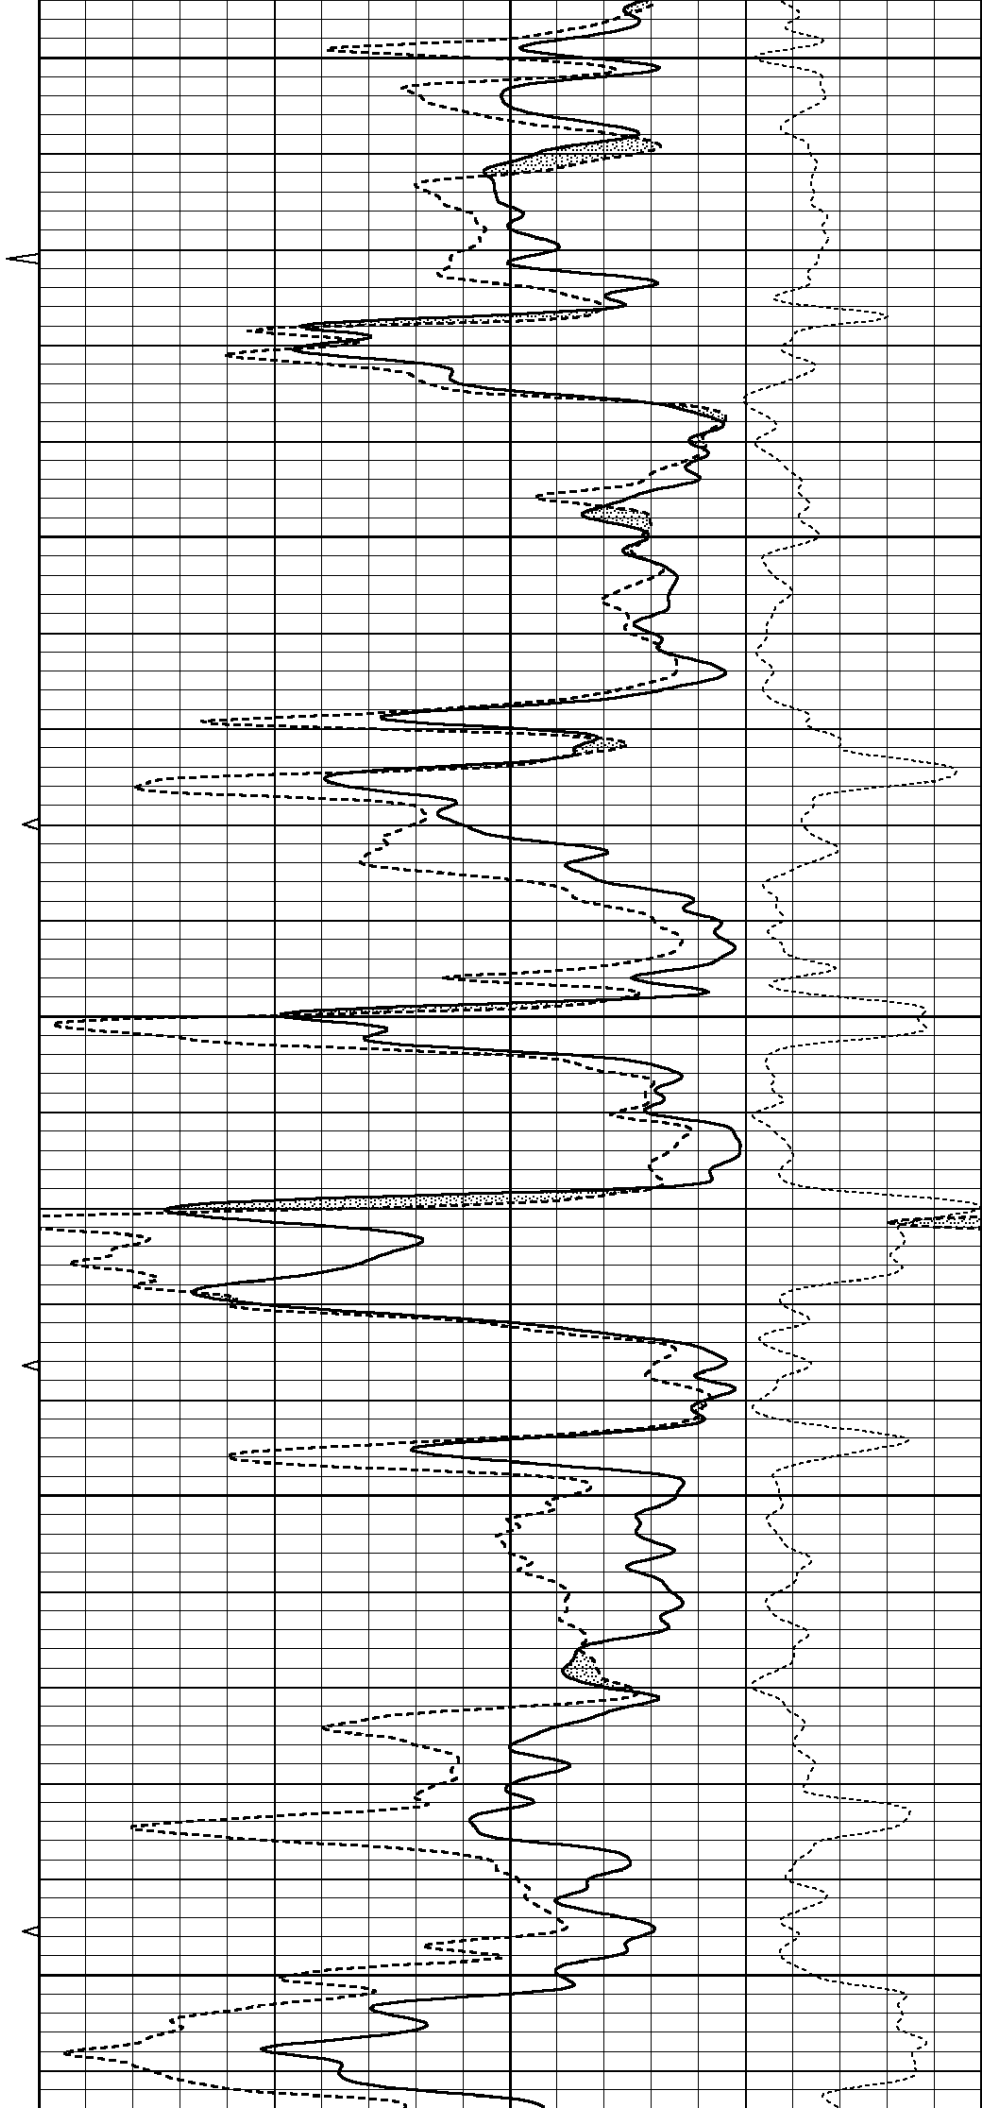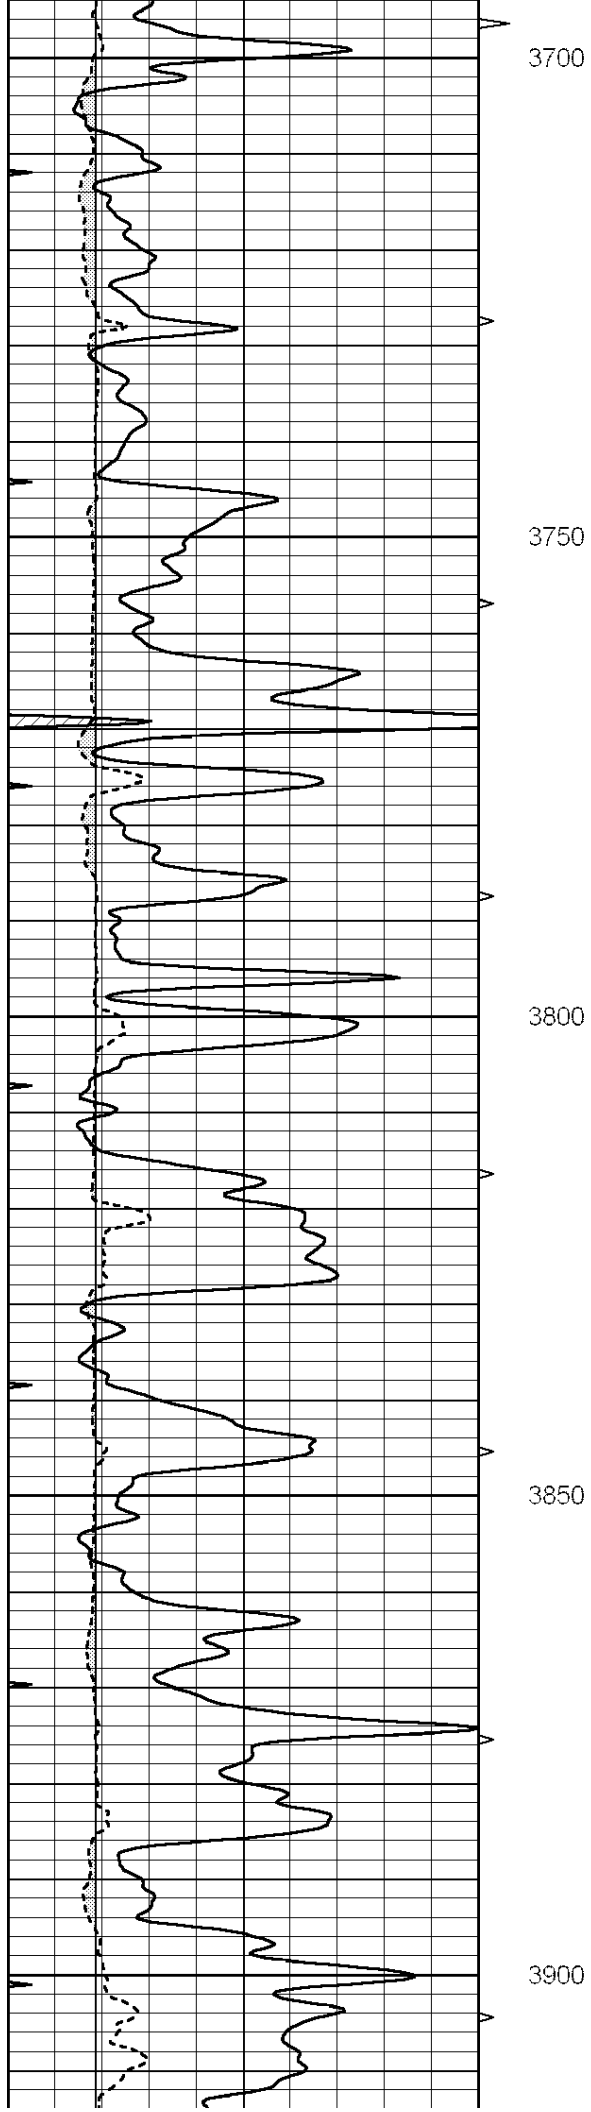

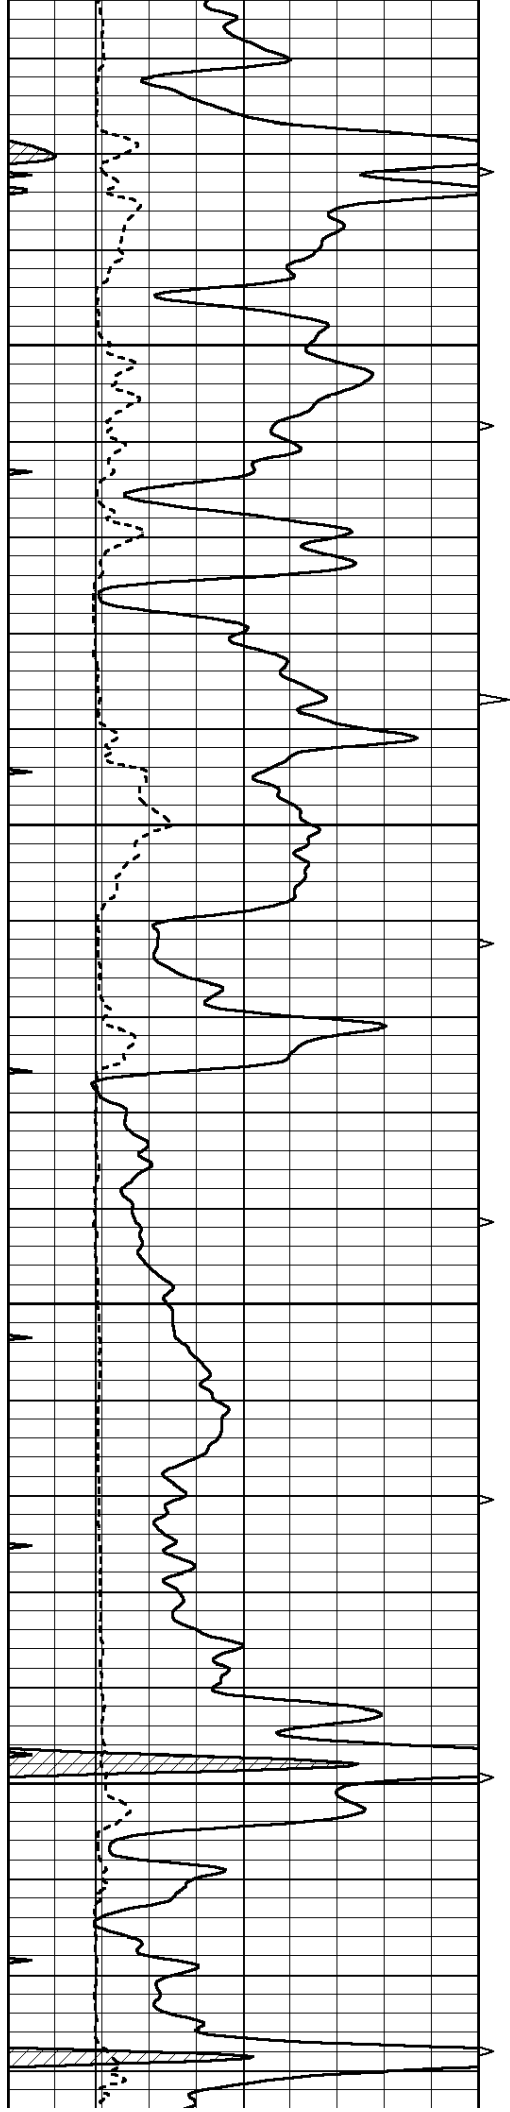



3950

4000

4050

4100

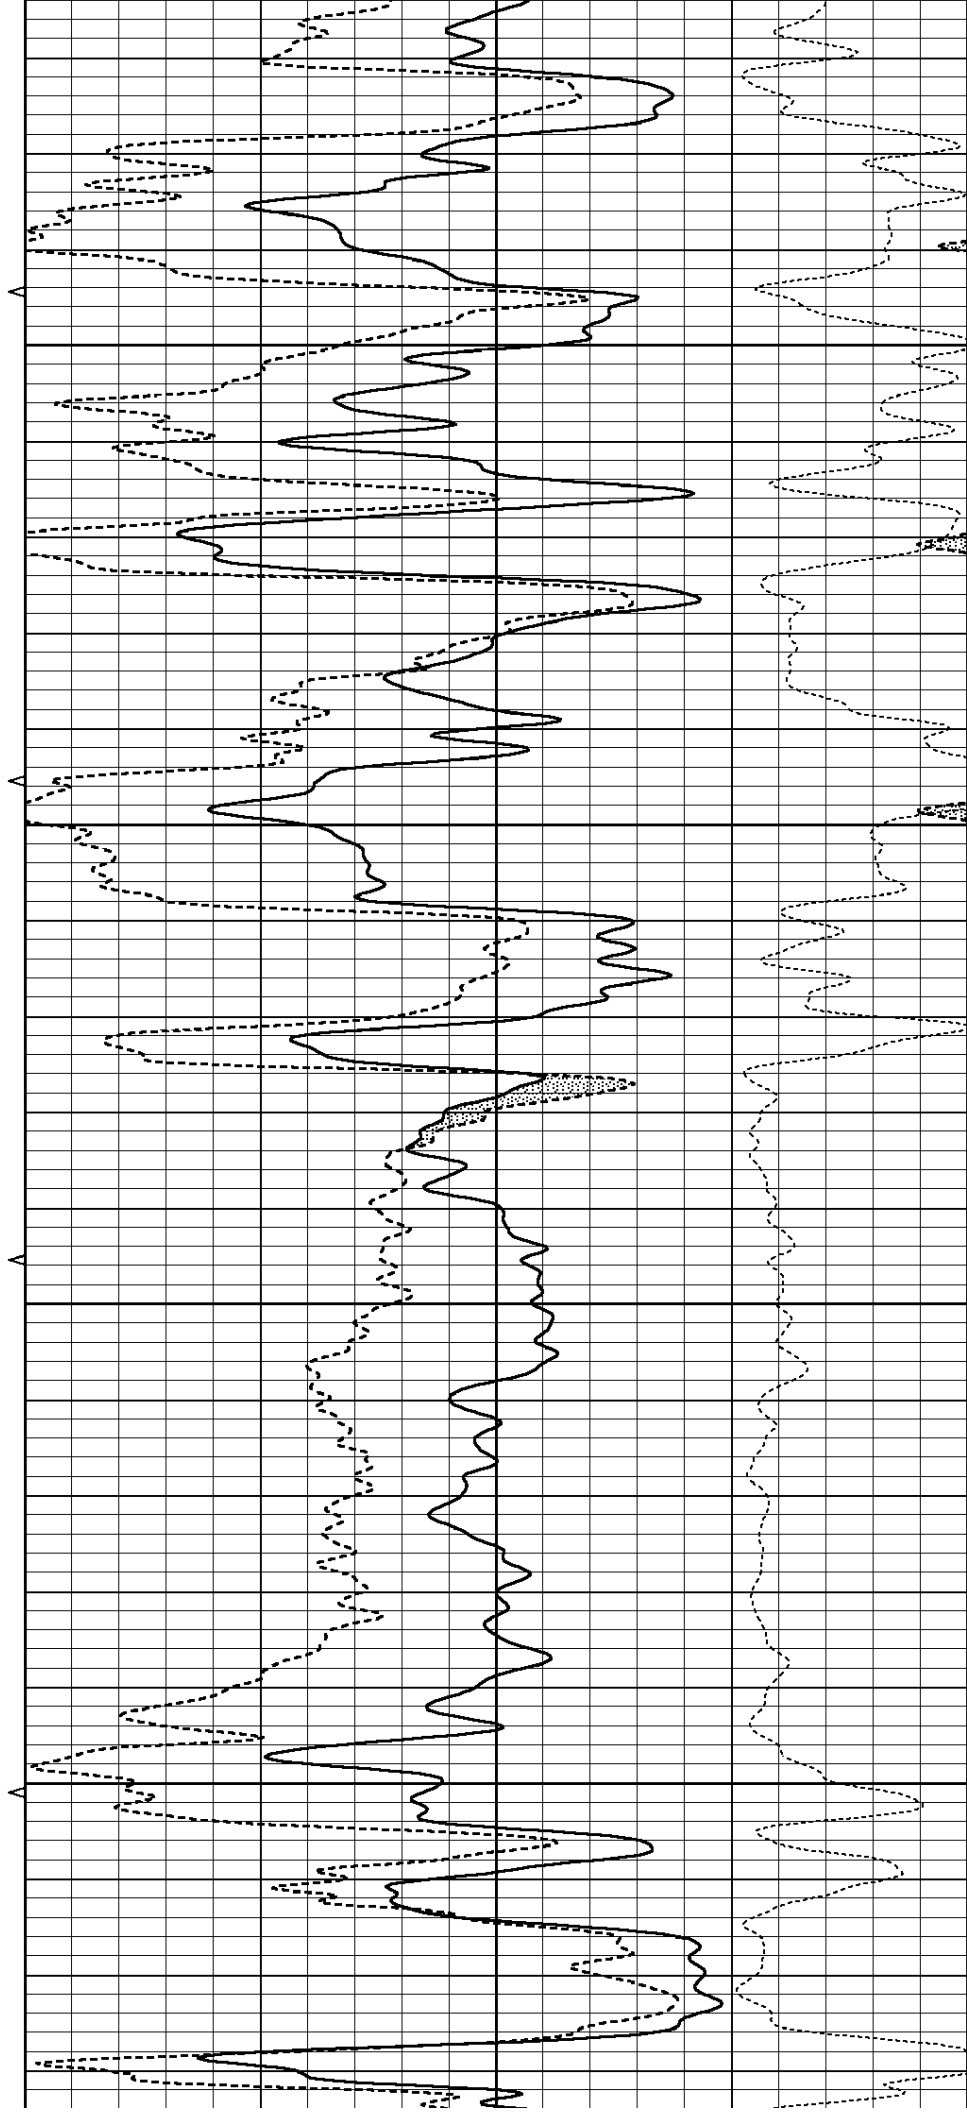

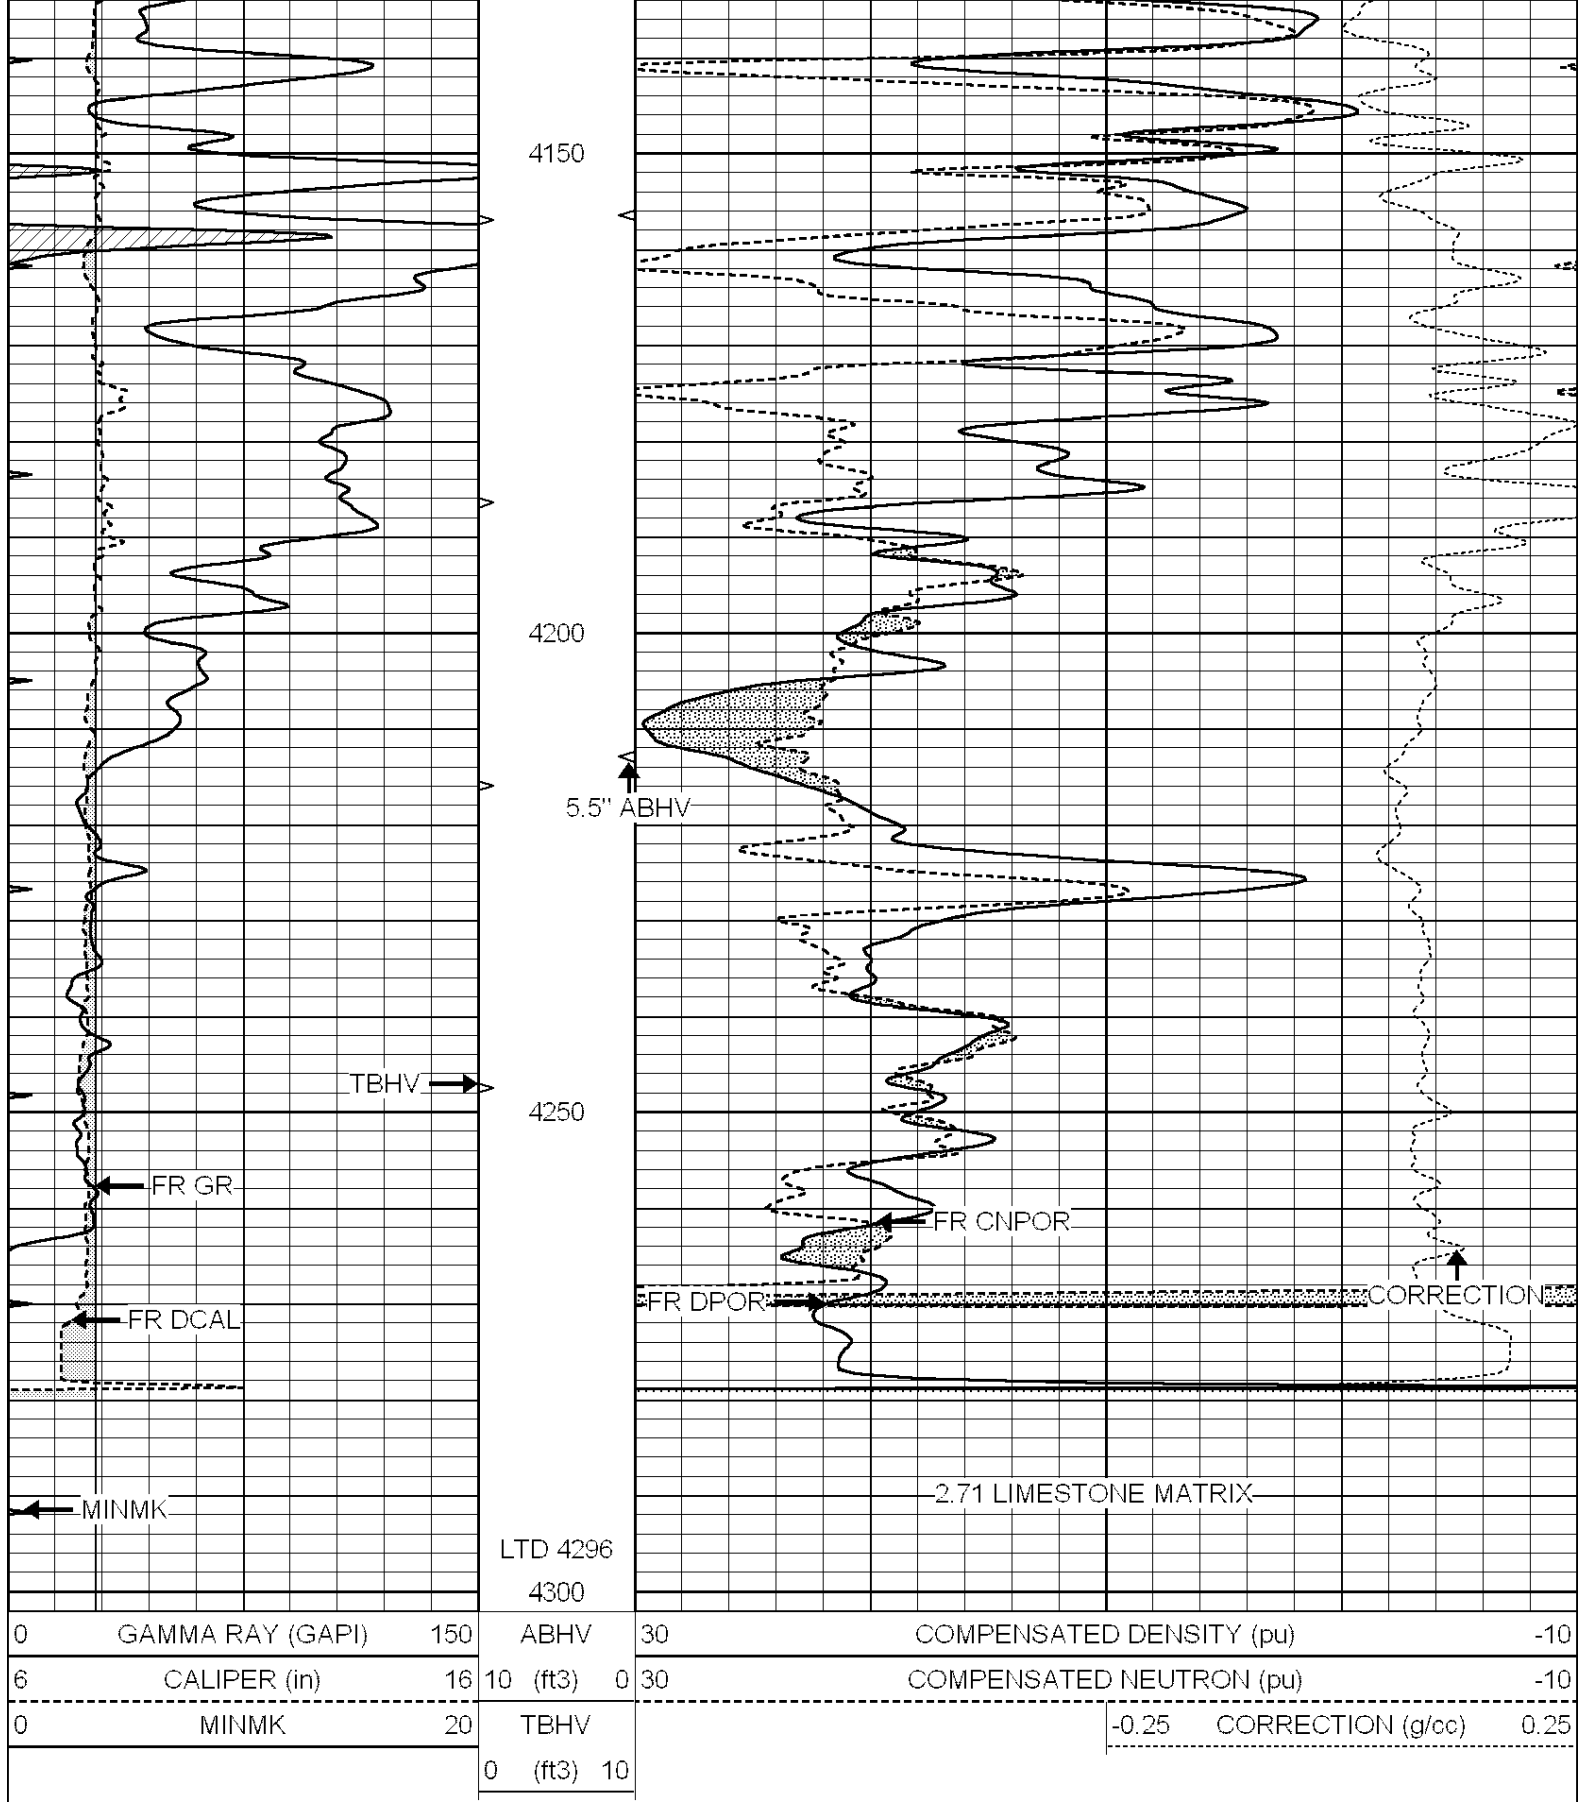


NABORS

**COMPLETION
& PRODUCTION
SERVICES CO.**

REPEAT SECTION

Dataset Pathname: pass2.5
Presentation Format: den_neu
Dataset Creation: Tue Sep 24 17:33:22 2013 by Calc SOC 120430
Charted by: Depth in Feet scaled 1:240

0	GAMMA RAY (GAPI)	150	ABHV	30	COMPENSATED DENSITY (pu)	-10
6	CALIPER (in)	16	10 (ft3)	0 30	COMPENSATED NEUTRON (pu)	-10
0	MINMK	20	TBHV		-0.25 CORRECTION (g/cc)	0.25
			0 (ft3)	10		

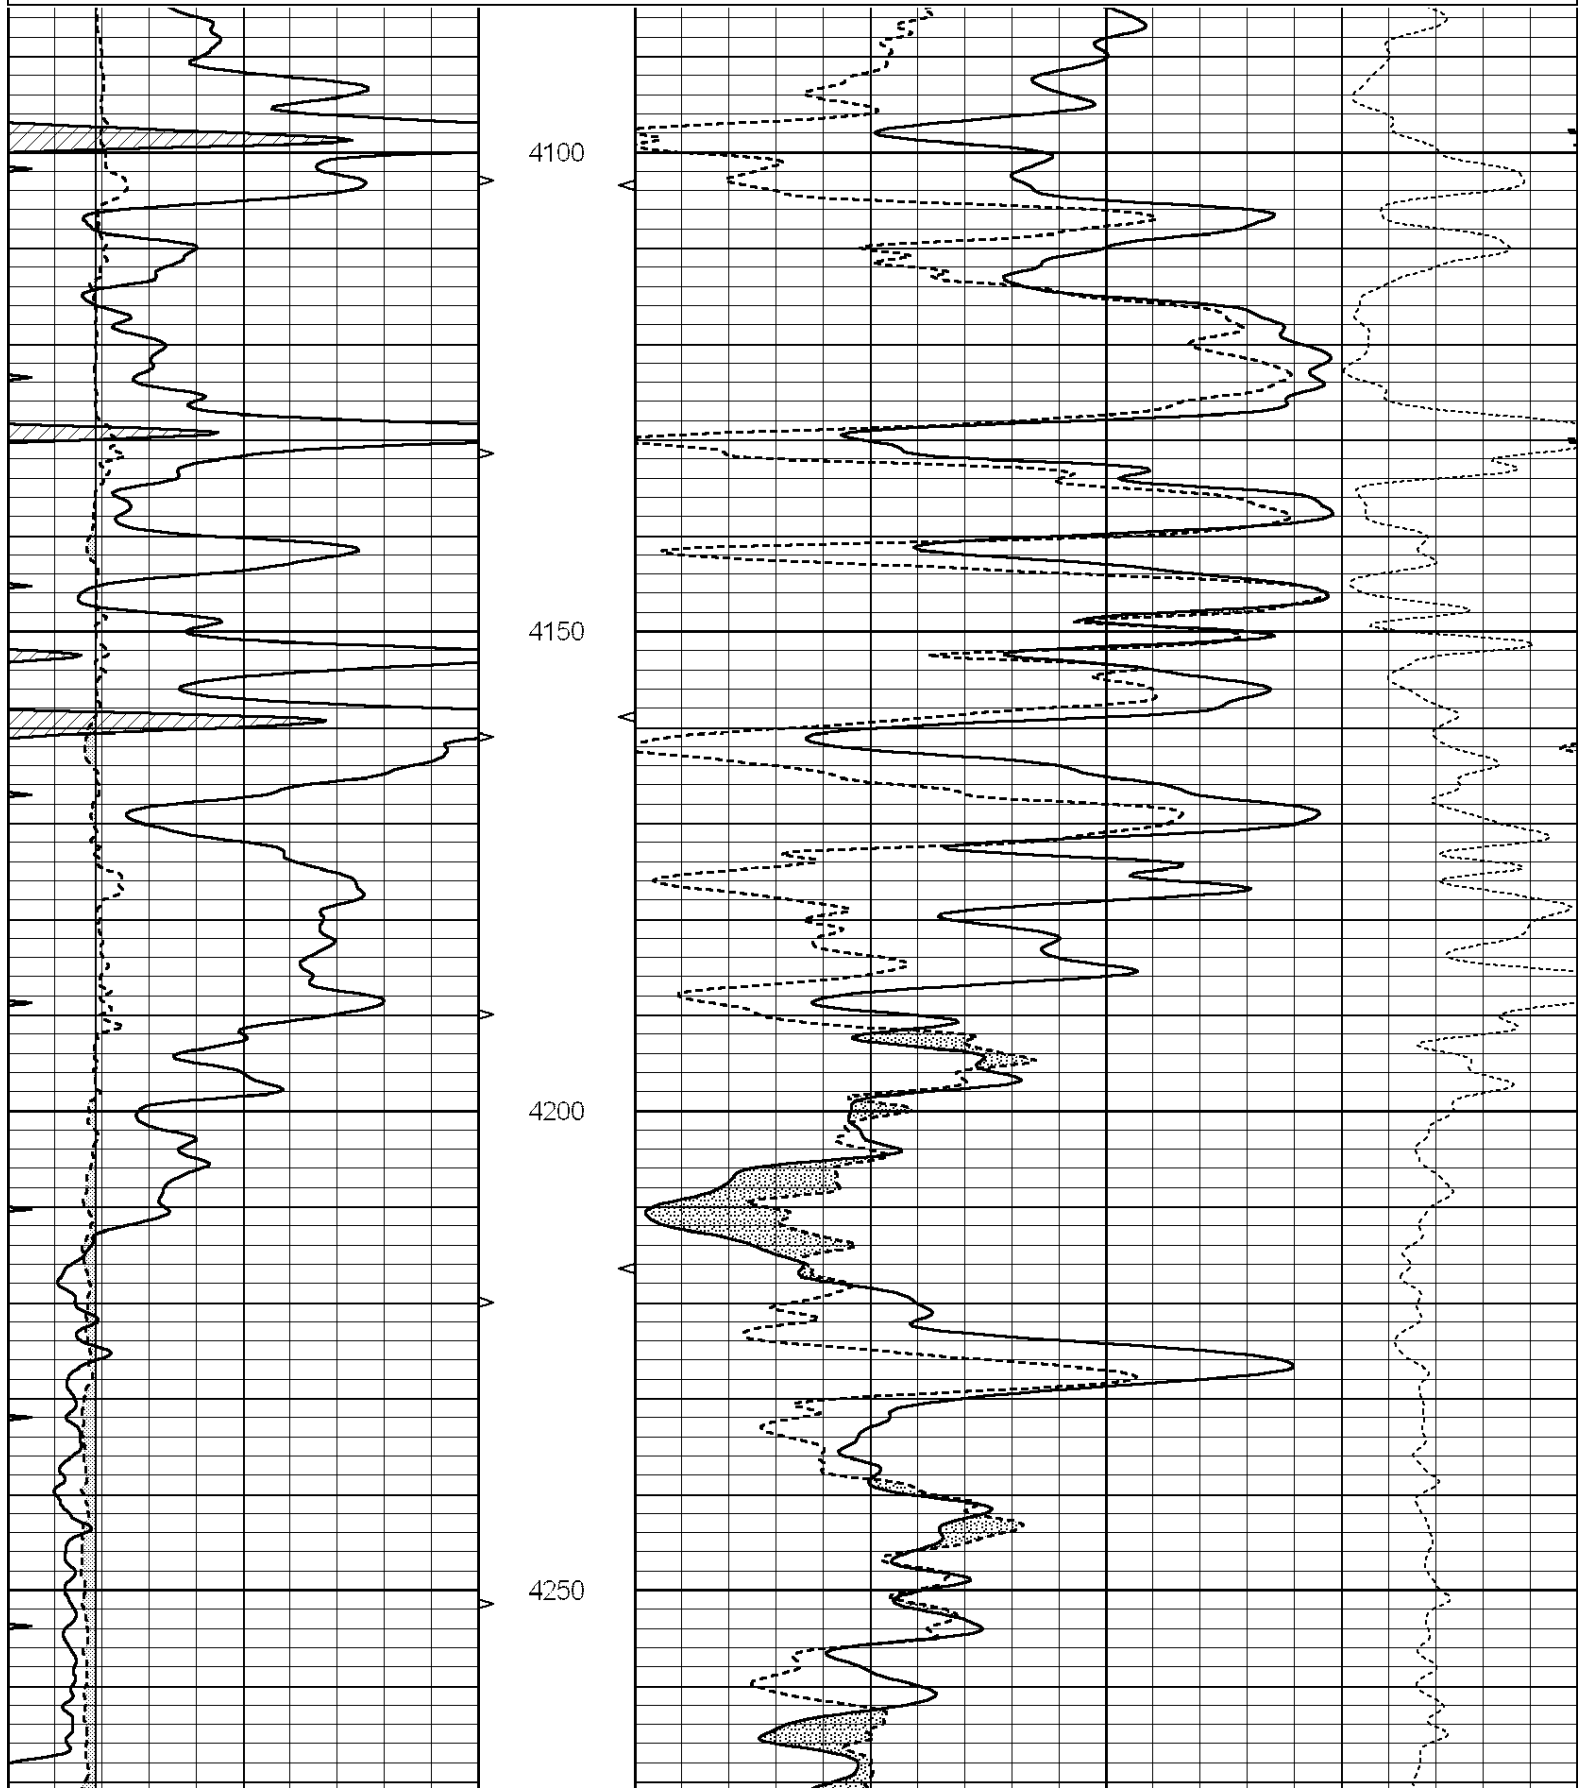

			4300					
0	GAMMA RAY (GAPI)	150	ABHV	30	COMPENSATED DENSITY (pu)			-10
6	CALIPER (in)	16	10 (ft3) 0	30	COMPENSATED NEUTRON (pu)			-10
0	MINMK	20	TBHV				-0.25	CORRECTION (g/cc) 0.25
			0 (ft3) 10					

Calibration Report

Database File: 011675ddh.db
Dataset Pathname: pass3.4
Dataset Creation: Tue Sep 24 18:04:13 2013 by Calc SOC 120430

Dual Induction Calibration Report

Serial-Model: PROBE9-DILG
Surface Cal Performed: Thu Sep 19 14:49:33 2013
Downhole Cal Performed: Mon Jul 28 12:02:56 2008
After Survey Verification Performed: Mon Jul 28 12:02:56 2008

Surface Calibration

Readings				References			Results	
Loop:	Air	Loop		Air	Loop		m	b
Deep	-0.014	0.629	V	0.000	400.000	mmho/m	621.923	-12.000
Medium	0.039	0.728	V	0.000	464.000	mmho/m	640.000	-19.000
Internal:	Zero	Cal		Zero	Cal		m	b
Deep	0.011	0.610	V	0.000	400.000	mmho/m	667.135	-7.256
Medium	0.005	0.712	V	0.000	464.000	mmho/m	655.677	-3.102

Downhole Calibration

Readings				References			Results	
	Zero	Cal		Zero	Cal		m'	b'
Deep	0.000	0.000	mmho/m	14.508	388.384	mmho/m	1.000	0.000
Medium	0.000	0.000	mmho/m	166.367	504.400	mmho/m	1.000	0.000
LL3		7.500	V		1400.000	Ohm-m		
		0.000	V		20.000	Ohm-m		
		-7.200	V		4000.000	mmho-m		

After Survey Verification

Readings				Targets			Results	
	Zero	Cal		Zero	Cal		m'	b'
Deep	0.000	0.000	mmho/m	0.000	0.000	mmho/m	0.000	0.000
Medium	0.000	0.000	mmho/m	0.000	0.000	mmho/m	0.000	0.000
LL3		1.000	Ohm-m		1.000	Ohm-m		
		0.000	Ohm-m		0.000	Ohm-m		
		1.000	mmho-m		1.000	mmho-m		

Litho Density Calibration Report
Serial: 001 Model: PRB

	Background	Magnesium	Aluminum	Sandstone	
Window 1	1890.3	12786.5	4236.7	13497.2	cps
Window 2	1764.1	11051.7	3765.5	11456.4	cps
Window 3	1442.8	5894.4	2376.2	5911.4	cps
Window 4	428.0	428.9	420.8	426.5	cps
Long Space	0.0	9287.6	2001.3	9692.3	cps
Short Space	3.2	3351.1	2186.8	3398.0	cps
Rho		1.7100	2.5900	1.3800	g/cc
Pe		0.0000	2.5700	1.5500	
Rib Angle	: 44.5	Rib Slope	: 0.981	Density/Spine Ratio	: 0.552
Spine Angle	: 74.5	Spine Slope	: 3.596	Spine Intercept	: -20.1

Before Survey Verification

Performed Wed Dec 31 18:00:00 1969

Window 1	0.0	0.0	0.0	0.0	cps
Window 2	0.0	0.0	0.0	0.0	cps
Window 3	0.0	0.0	0.0	0.0	cps
Window 4	0.0	0.0	0.0	0.0	cps
Long Space	0.0	0.0	0.0	0.0	cps
Short Space	0.0	0.0	0.0	0.0	cps
Measured Rho		0.0000	0.0000	0.0000	g/cc
Measured Correction		0.0000	0.0000	0.0000	g/cc
Measured Pe			0.0000	0.0000	

After Survey Verification

Performed Wed Dec 31 18:00:00 1969

Window 1	0.0	0.0	0.0	0.0	cps
Window 2	0.0	0.0	0.0	0.0	cps
Window 3	0.0	0.0	0.0	0.0	cps
Window 4	0.0	0.0	0.0	0.0	cps
Long Space	0.0	0.0	0.0	0.0	cps
Short Space	0.0	0.0	0.0	0.0	cps
Measured Rho		0.0000	0.0000	0.0000	g/cc
Measured Correction		0.0000	0.0000	0.0000	g/cc
Measured Pe			0.0000	0.0000	

Compensated Neutron Calibration Report

Serial Number: 070808
Tool Model: Probe

PRE-SURVEY VERIFICATION

Detector	Readings	Measured	Target
Short Space	cps		
Long Space	cps	pu	pu

POST-SURVEY VERIFICATION

Detector	Readings	Measured	Target
Short Space	cps		
Long Space	cps	pu	pu

Gamma Ray Calibration Report

Serial Number:	070559
Tool Model:	OPEN_GR
Performed:	Wed Jun 12 18:25:42 2013

Calibrator Value:	1.0	GAPI
-------------------	-----	------

Background Reading:	0.0	cps
Calibrator Reading:	1.0	cps

Sensitivity:	0.3500	GAPI/cps
--------------	--------	----------