MIDWEST SURVEYS
LOGGING PERFORATING CONSULTING SERVICES
P.O. Box 413 Chanute, KS 66720
913 765 2135

GAMMA RAY / NEUTRON / CCL

File No.

API # 15-059-25,687

Company BG- 5, Inc.
Well JE Burkdoll No. - 19
Field Paola / Rantoul
County Franklin State Kansas
Location 2115' FSL & 1450' FEL
SE-NE-NW-SE
Sec. 13 Twp. 18S Rge. 20E

Permanent Datum GL Elevation 1HA
Log Measured From KB 1HA Above Perm. Datum
Drilling Measured From GL

Date 5-23-2011
Run Number One
Depth Driller 783.5
Depth Logger 781.5
Bottom Logged Interval 781.5
Top Logged Interval Surface
Fluid Level Full
Type Fluid in Hole Water
Salinity, PPM Cl N/A
Density / Viscosity
Max. Rec. Temperature
Equipment No. 104 Operating Rig Time
Location
Recorded By Shane Burdick
Witnessed By

Perforate
Other Services
DIP 1HA
DLL 1HA
CCL 1HA

BOREHOLE RECORD

RUN	BIT	FROM	TO
One	6 3/4"	0.0	200

CASING RECORD

RUN	SIZE	WGT	FROM	TO
One	8 5/8"	20#	0.0	779.0

>>> Fold Here <<<


All interpretations are opinions based on inferences from electrical or other measurements and we cannot and do not guarantee the accuracy or correctness of any interpretation, and we shall not, except in the case of gross or willful negligence on our part, be liable or responsible for any loss, costs, damages, or expenses incurred or sustained by anyone resulting from any interpretation made by any of our officers, agents or employees. These interpretations are also subject to our general terms and conditions set out in our current Price Schedule.

Comments

Drilling Contractor :
Town Oil Company

Database File: je19.db
Dataset Pathname: pass1
Presentation Format: gr-n-ccl
Dataset Creation: Fri Sep 30 12:43:09 2011 by Log Warrior Version 6.6
Charted by: Depth in Feet scaled 1:240

0 Gamma Ray 150
150 Gamma Ray 300
100 Neutron 1800

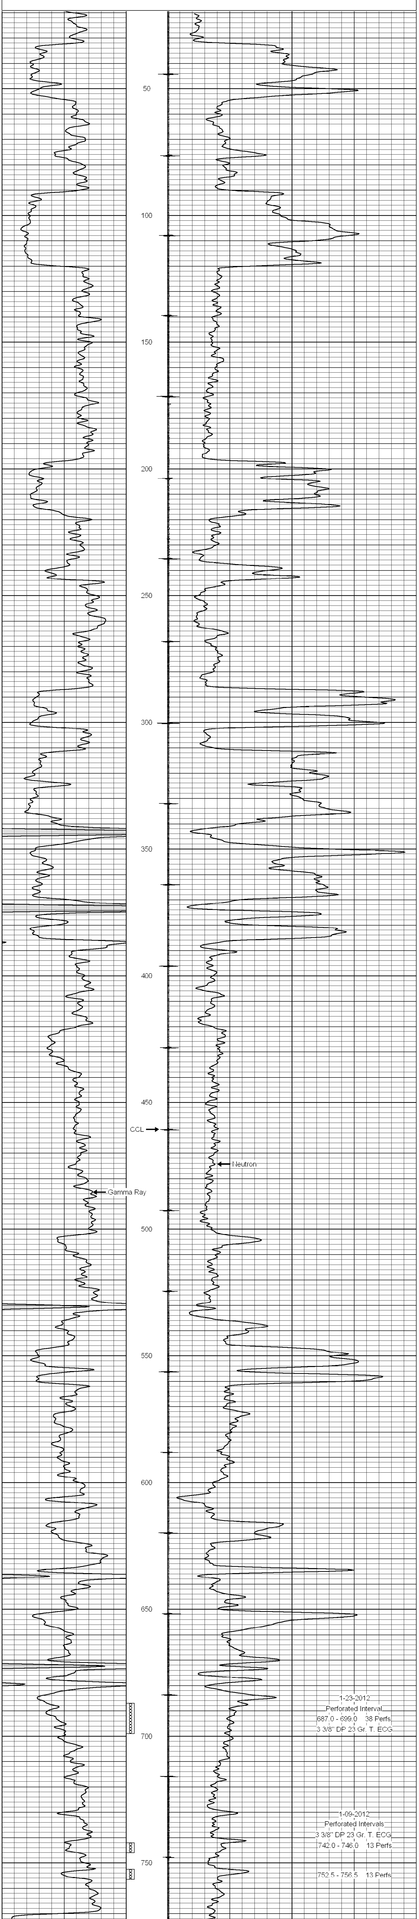

0 Gamma Ray 150
150 Gamma Ray 300
100 Neutron 1800