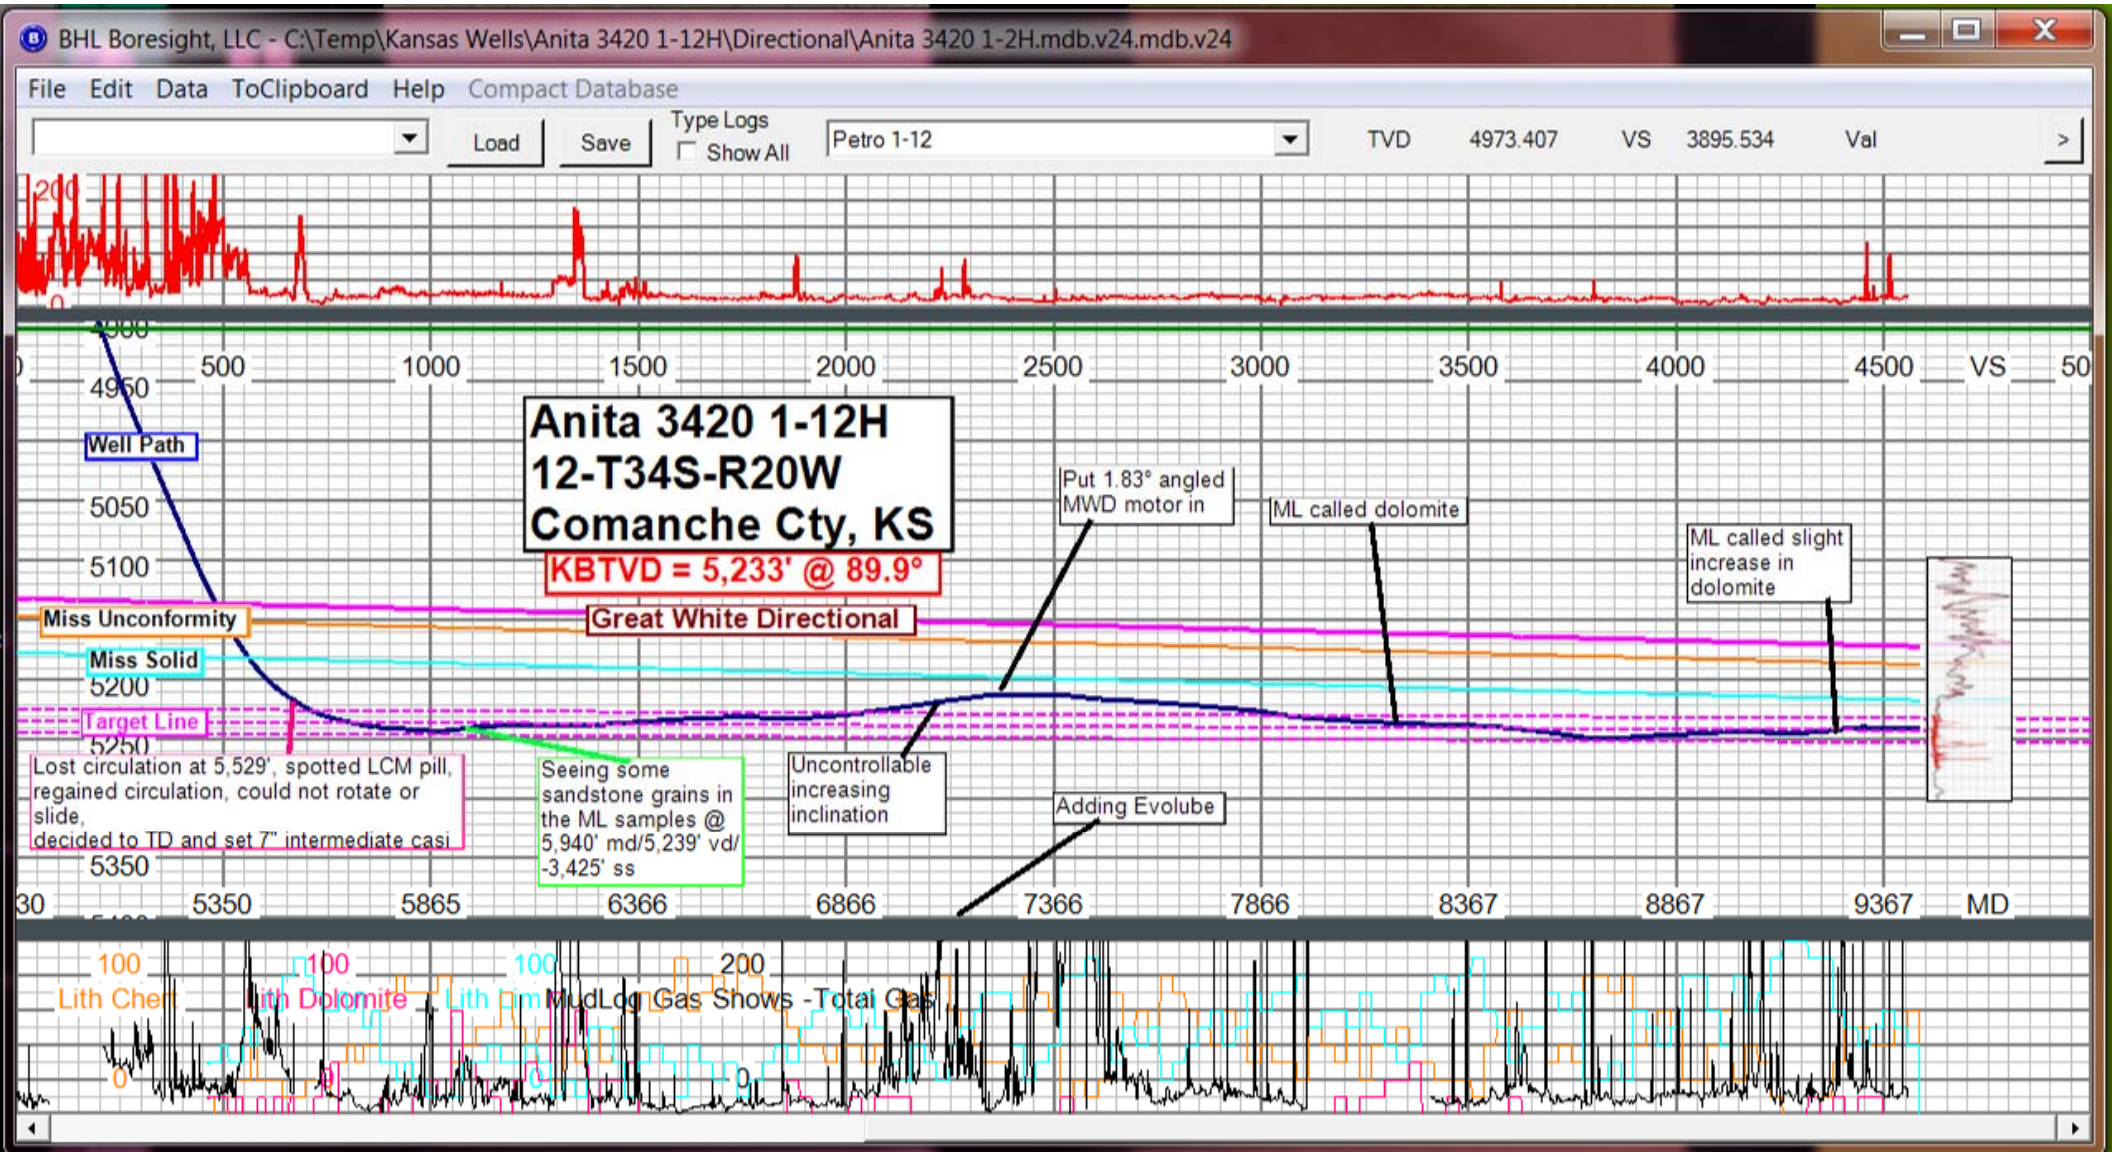
BHL Boresight, LLC - C:\Temp\Kansas Wells\Anita 3420 1-12H\Directional\Anita 3420 1-2H.mdb.v24.mdb.v24
File Edit Data ToClipboard Help Compact Database
Load
Save
Type Logs
Show All
Petro 1-12
TVD 4973.407 VS 3895.534 Val
Anita 3420 1-12H
12-T34S-R20W
Comanche Cty, KS
KBTVD = 5,233' @ 89.9°
Well Path
Miss Unconformity
Great White Directional
Miss Solid
Target Line
Put 1.83° angled MWD motor in
ML called dolomite
ML called slight increase in dolomite
Lost circulation at 5,529', spotted LCM pill, regained circulation, could not rotate or slide, decided to TD and set 7" intermediate casi
Seeing some sandstone grains in the ML samples @ 5,940' md/5,239' vd/ -3,425' ss
Uncontrollable increasing inclination
Adding Evolube
VS
MD
MudLog Gas Shows - Total Gas