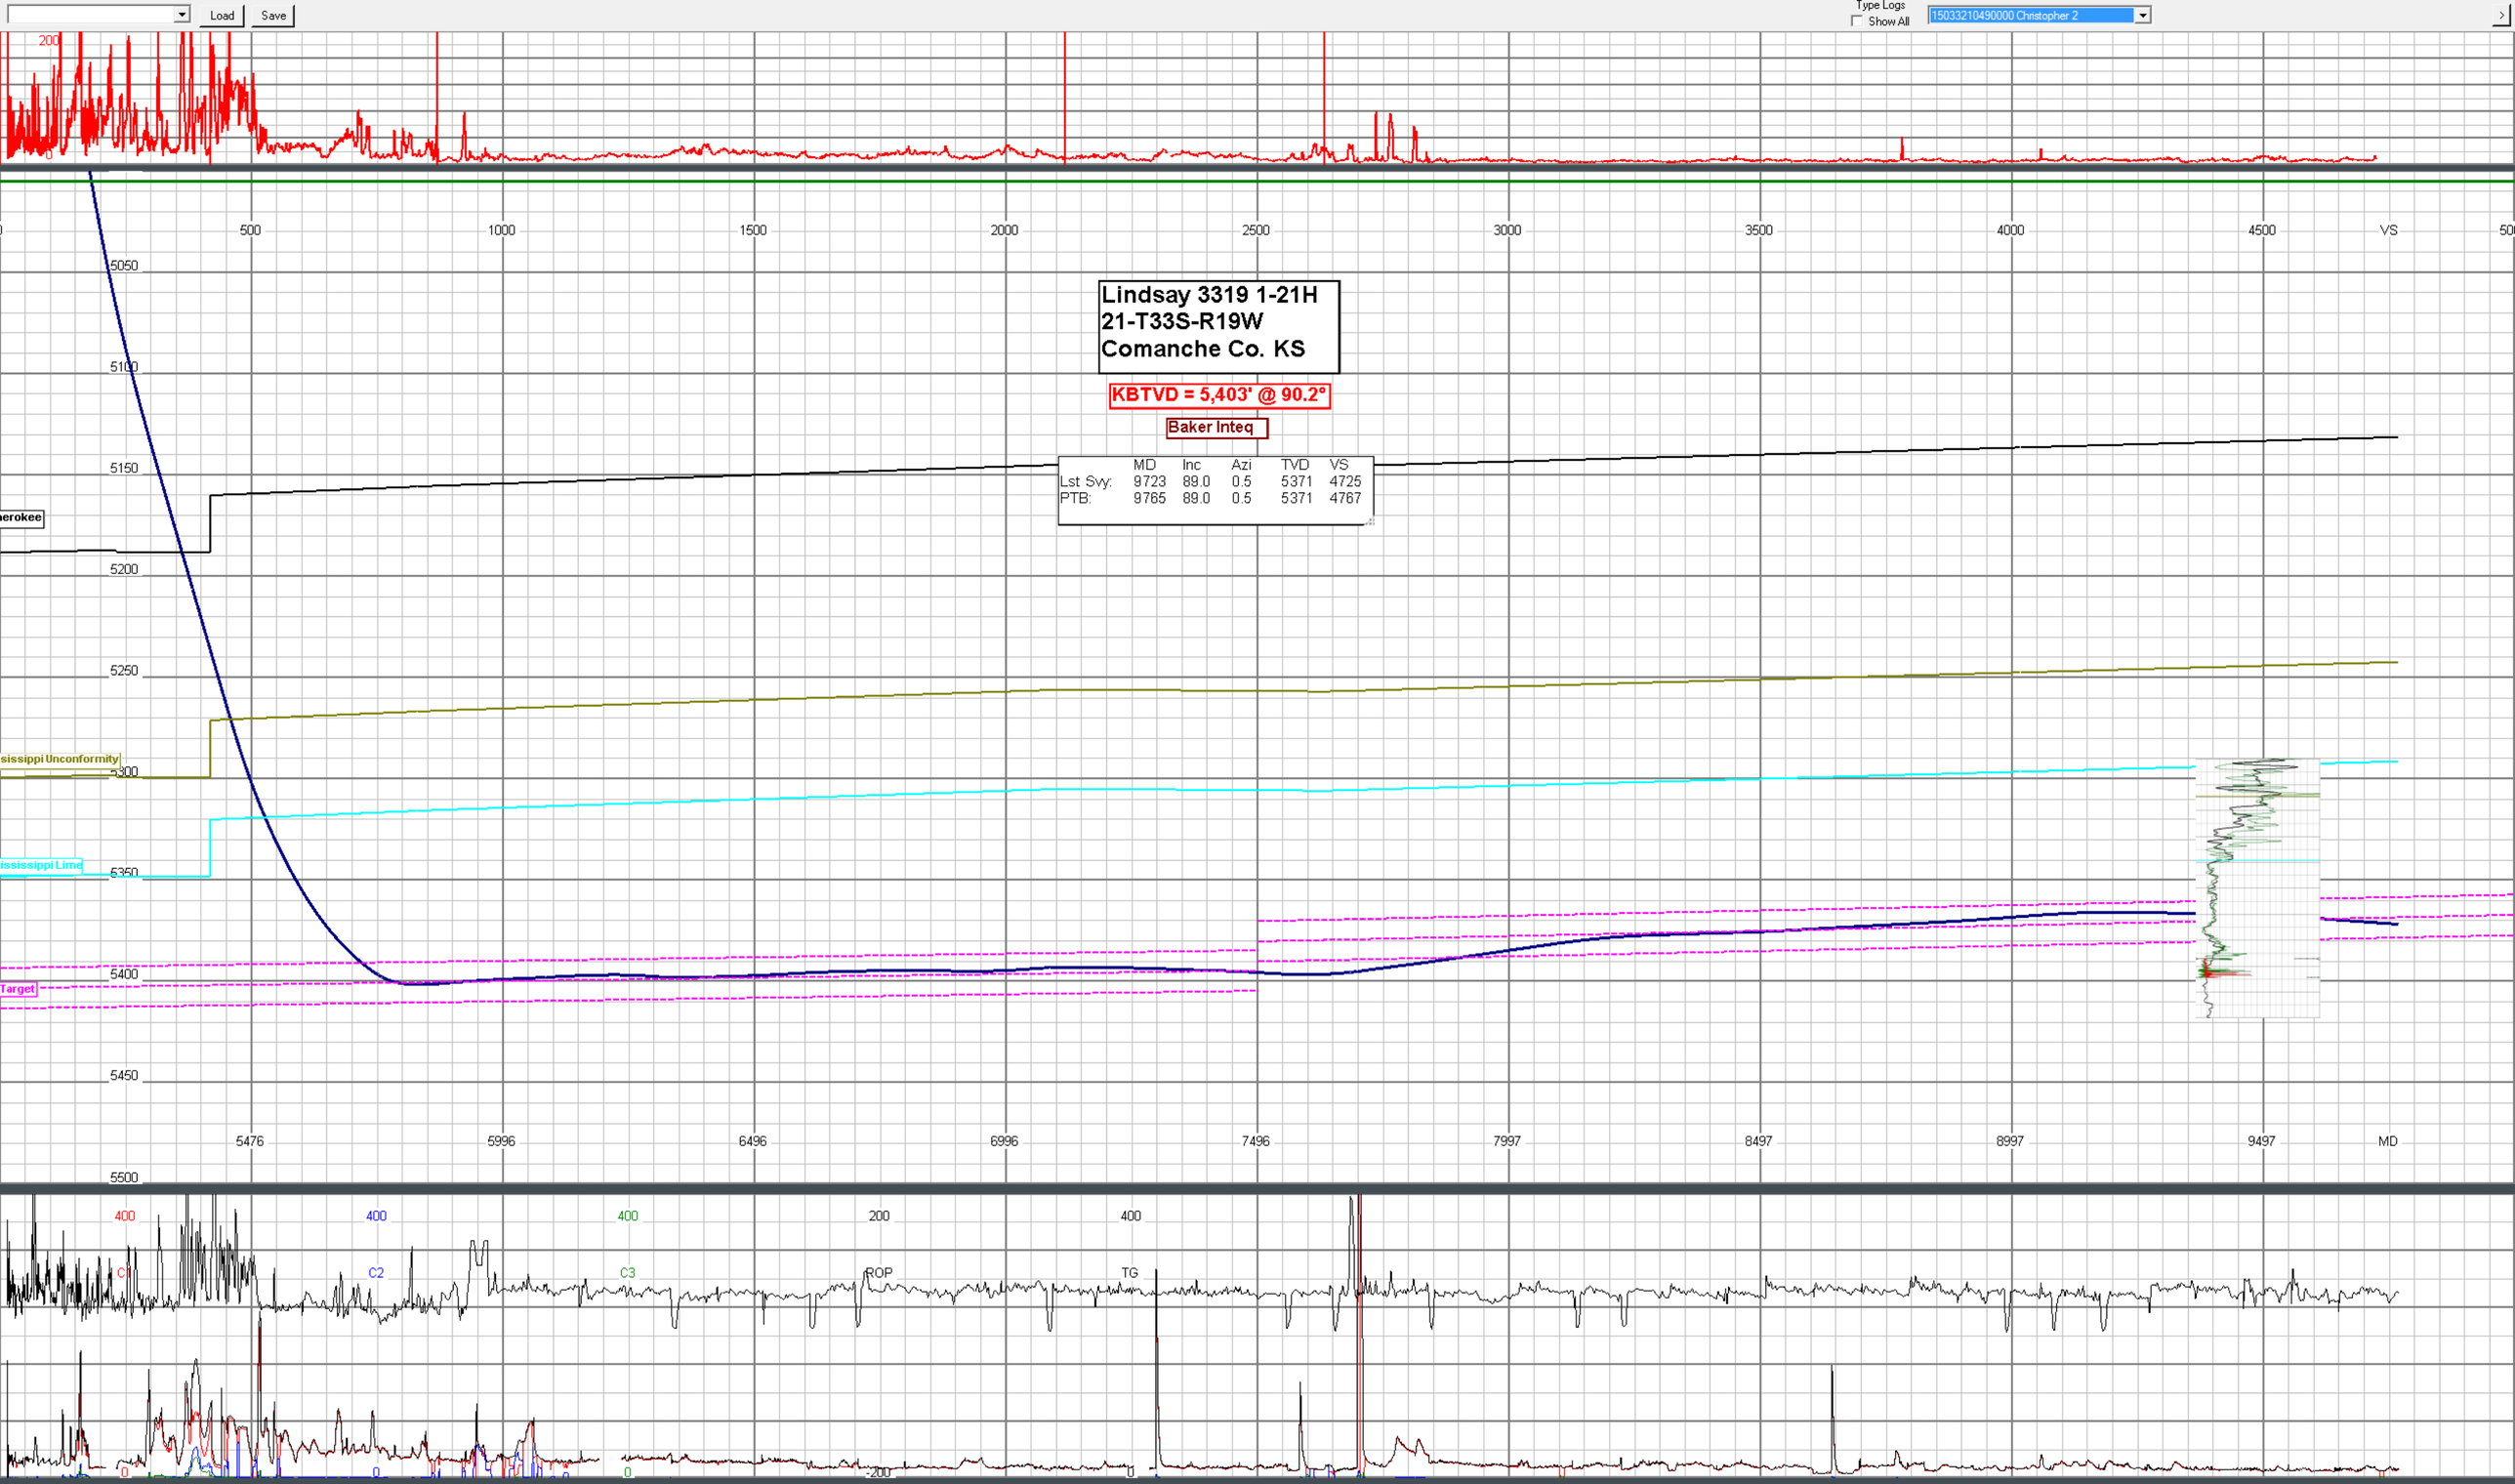
Load
Save
Type Logs
Show All
15033210490000 Christopher 2
Lindsay 3319 1-21H
21-T33S-R19W
Comanche Co. KS
KBTVD = 5,403' @ 90.2°
Baker Inteq
MD Inc Azi TVD VS
Lst Svy: 9723 89.0 0.5 5371 4725
PTB: 9765 89.0 0.5 5371 4767
500
1000
1500
2000
2500
3000
3500
4000
4500
VS
5050
5100
5150
5200
5250
5300
5350
5400
5450
5500
erokee
sissippi Unconformity
ississippi Lime
Target
5476
5996
6496
6996
7496
7997
8497
8997
9497
MD
400
C1
400
C2
400
C3
200
ROP
400
TG
0
0
0
-200
0