




0	Gamma Ray	150
6	Caliper (GAPI)	16

30	Compensated Density	-10
2	Bulk Density	3
15000	Line Tension	0
-0.25	Correction	0.25
LSPD		

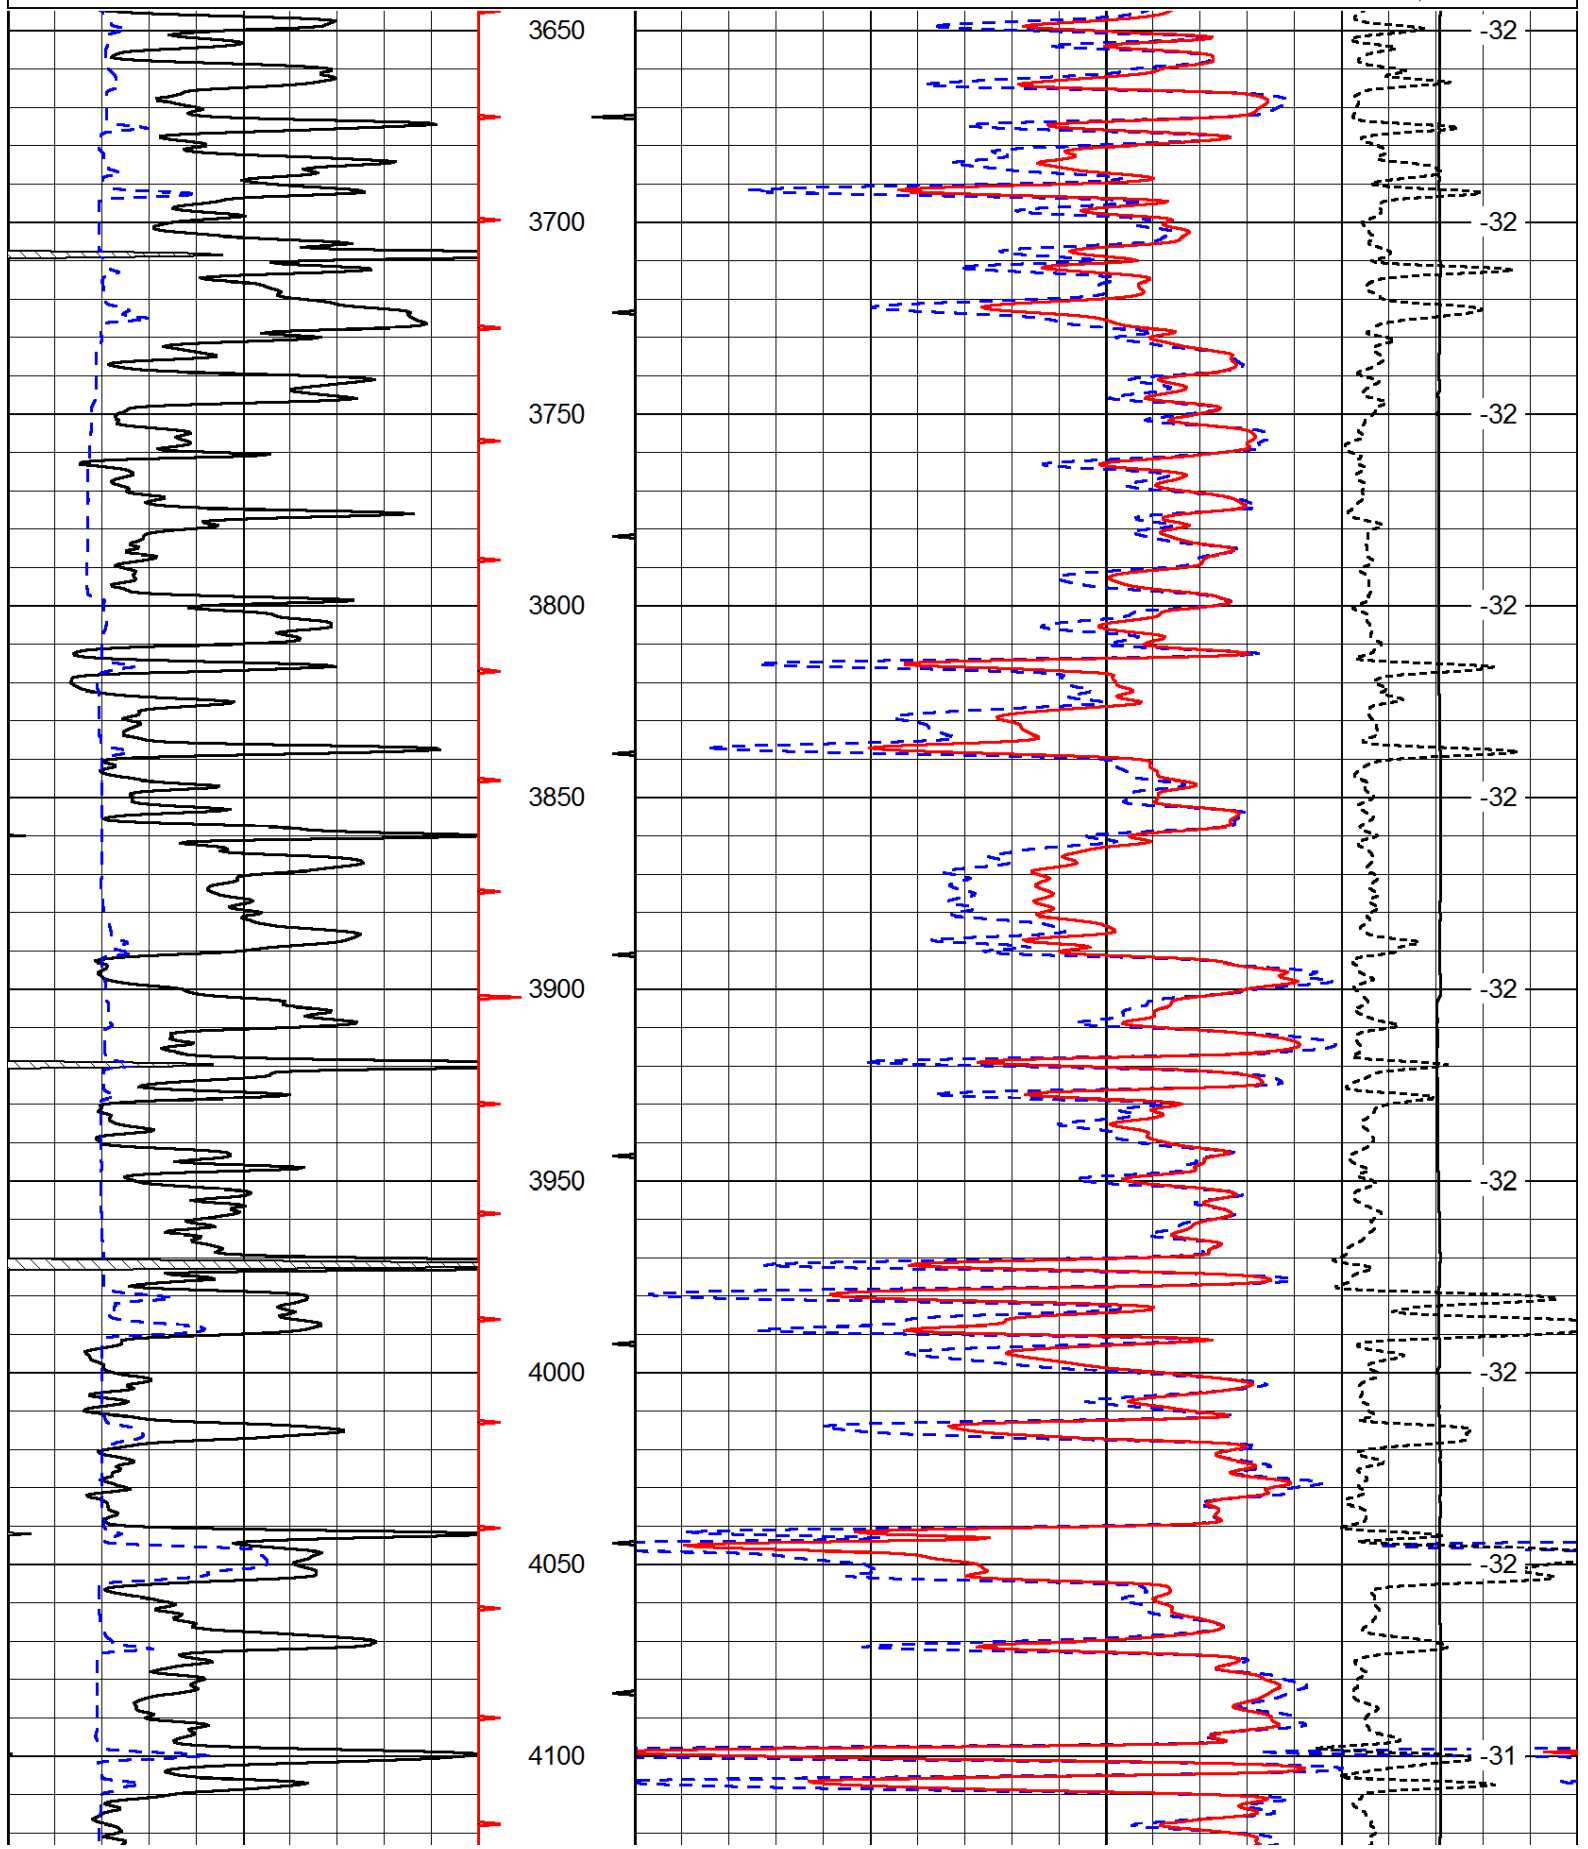

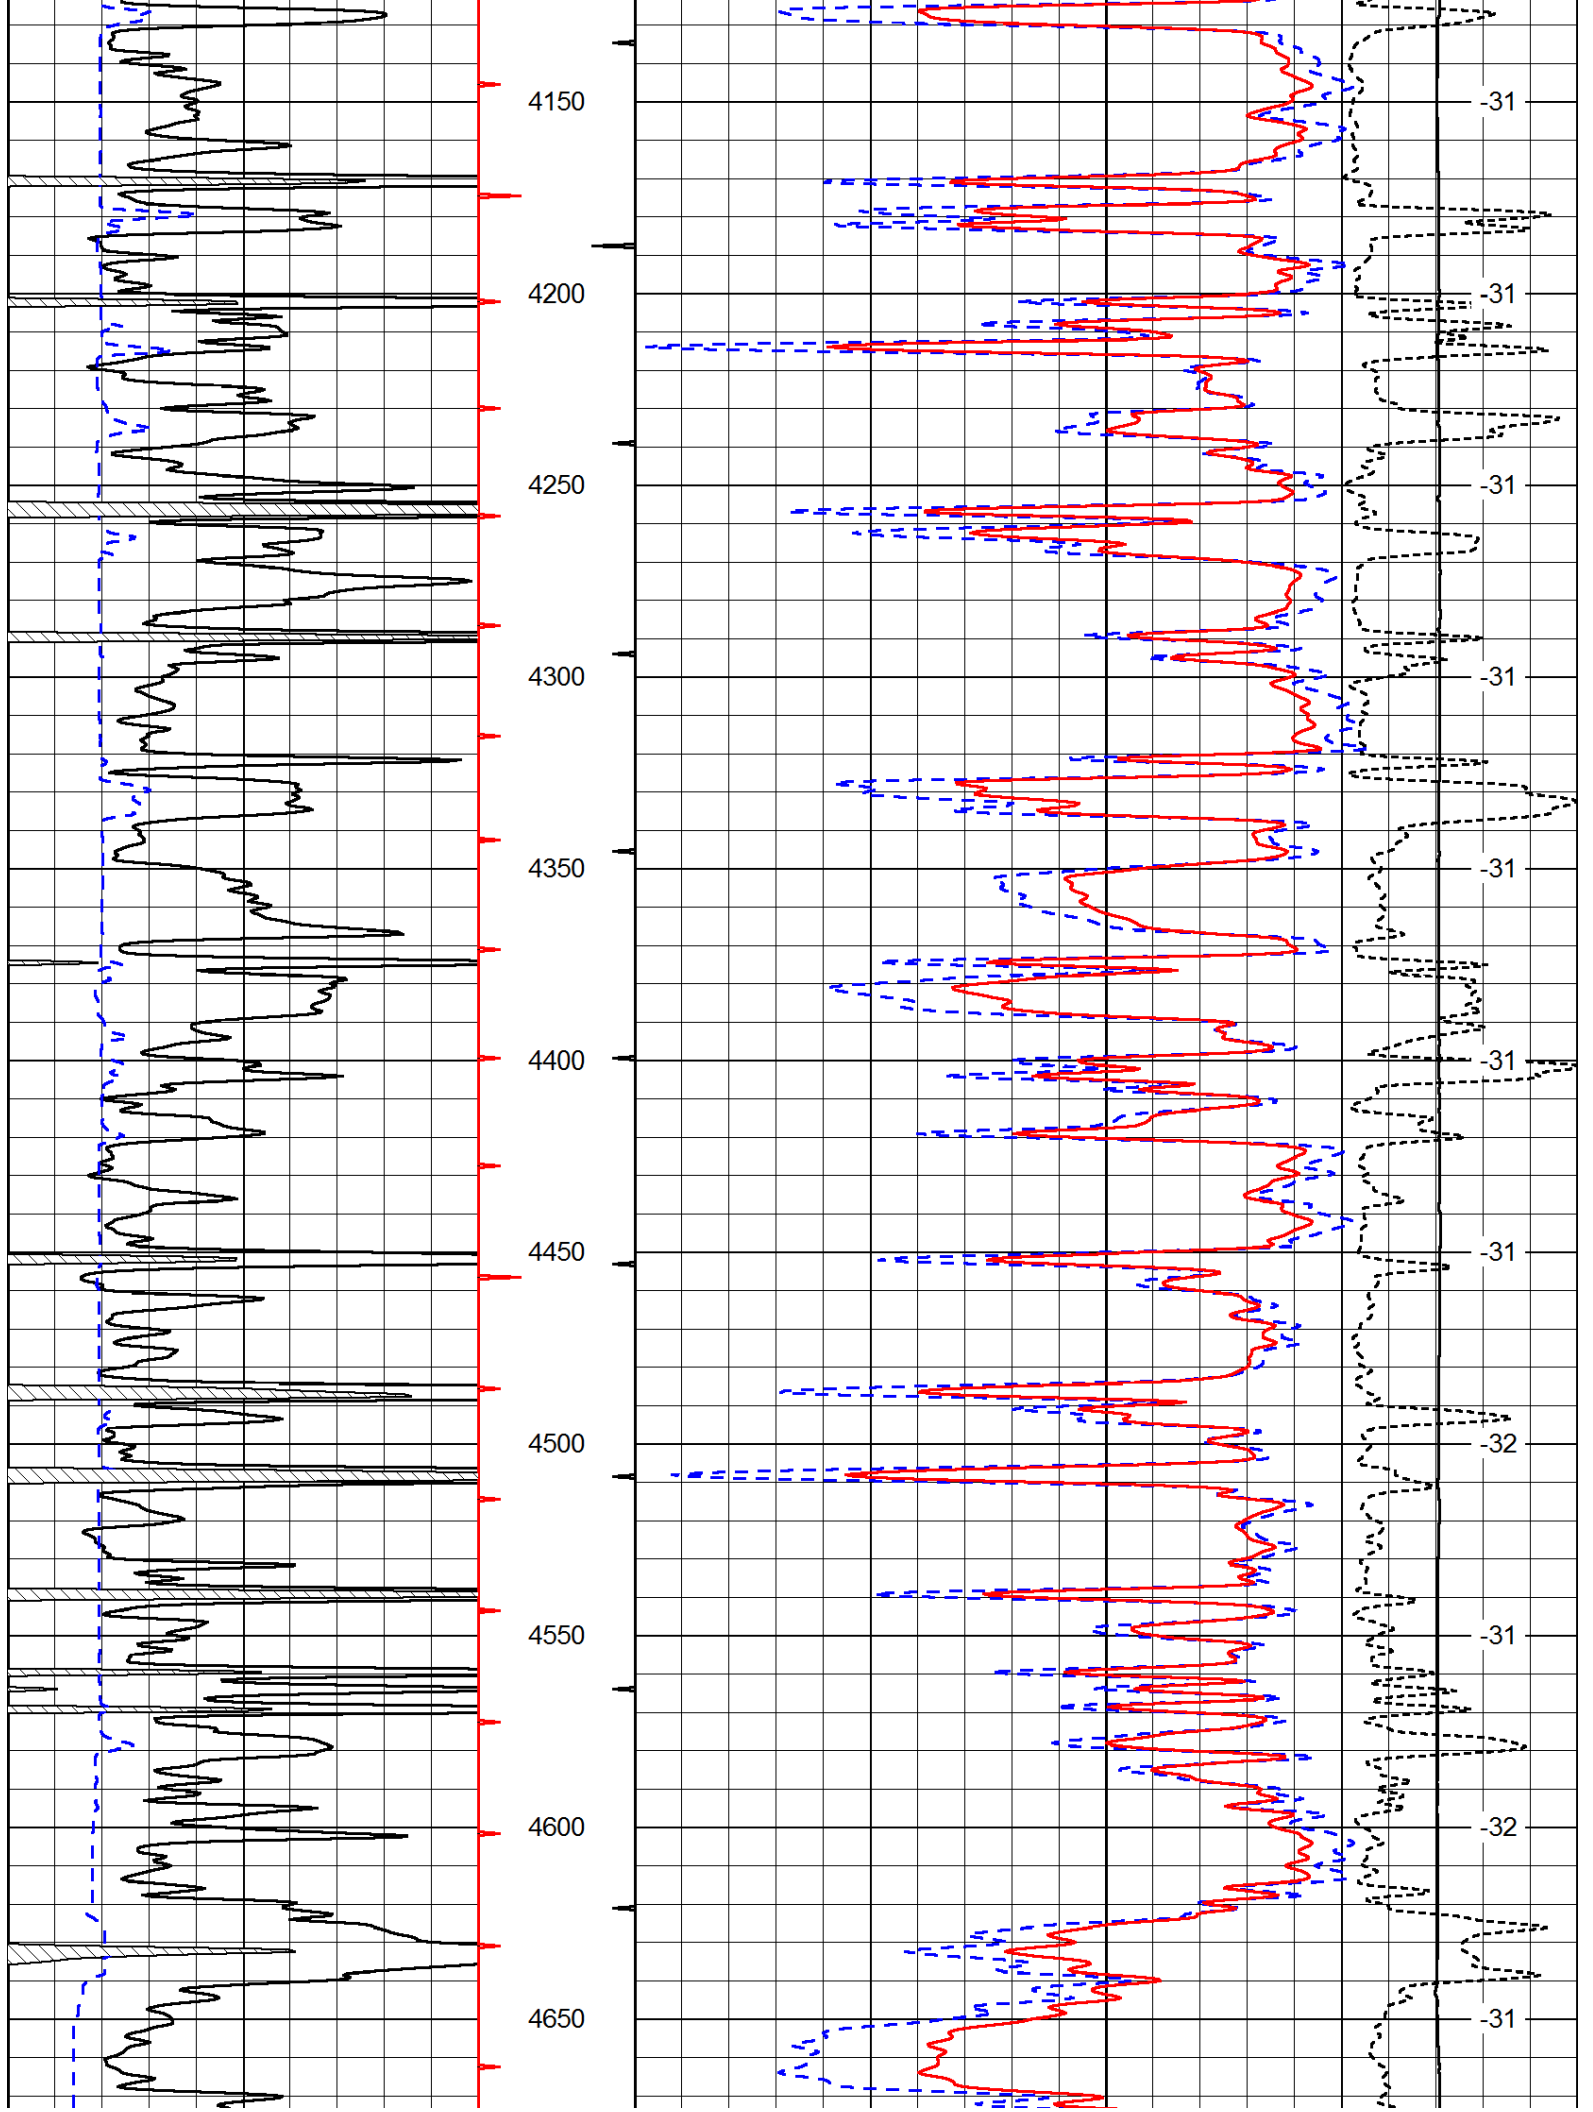

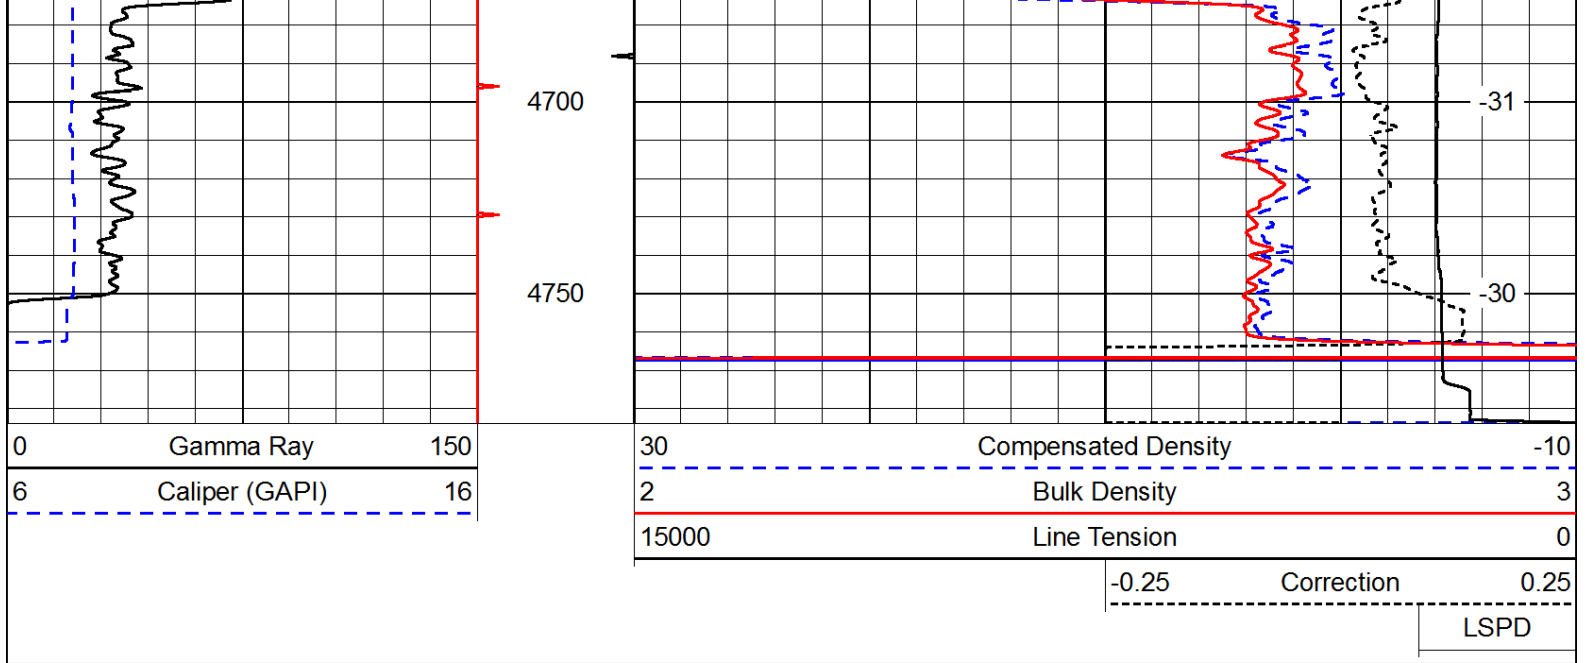

Database File: c:\warrior\data\murfin_racette #2-12\murfin_racette_2_12hd.db
 Dataset Pathname: DIL/murfstk
 Presentation Format: cndlspec
 Dataset Creation: Sun Apr 20 12:00:05 2014
 Charted by: Depth in Feet scaled 1:240

