



# MIDWEST SURVEYS

LOGGING - PERFORATING - CONSULTING SERVICES  
 P.O. Box 68, Osawatomie, KS 66064  
 913 / 755 - 2128

## GAMMA RAY / NEUTRON / CCL

File No.

API # 15-107-24,029


Company **Bobcat Oilfield Service, Inc.**  
 Well **Snyder No. S-18**  
 Field **Cadmus - LaCygne**  
 County **Linn** State **Kansas**

Location		Other Services
4180' FSL & 1271' FEL SW-SW-NE-NE		Perforate
Sec. 8	Twp. 20s	Rge. 23e
Permanent Datum	GL	Elevation NA
Log Measured From	GL	K.B. NA
Drilling Measured From	GL	D.F. NA
		G.L. NA

Date	6-02-2009
Run Number	One
Depth Driller	341.0
Depth Logger	334.0
Bottom Logged Interval	332.0
Top Log Interval	20.0
Fluid Level	Full
Type Fluid	Water
Density / Viscosity	NA
Salinity - PPM Cl	NA
Max Recorded Temp	NA
Estimated Cement Top	0.0
Equipment No.	104
Location	Osawatomie
Recorded By	Gary Windisch
Witnessed By	Bob Eberhart

RUN No.	BORE-HOLE RECORD				CASING RECORD		
	BIT	FROM	TO	SIZE	WGT.	FROM	TO
One	8.75"	0.0	20.6	6.625"		0.0	20.6
Two	5.625"	20.6	341.0	2.875"		0.0	335.0

Fold Here >>>

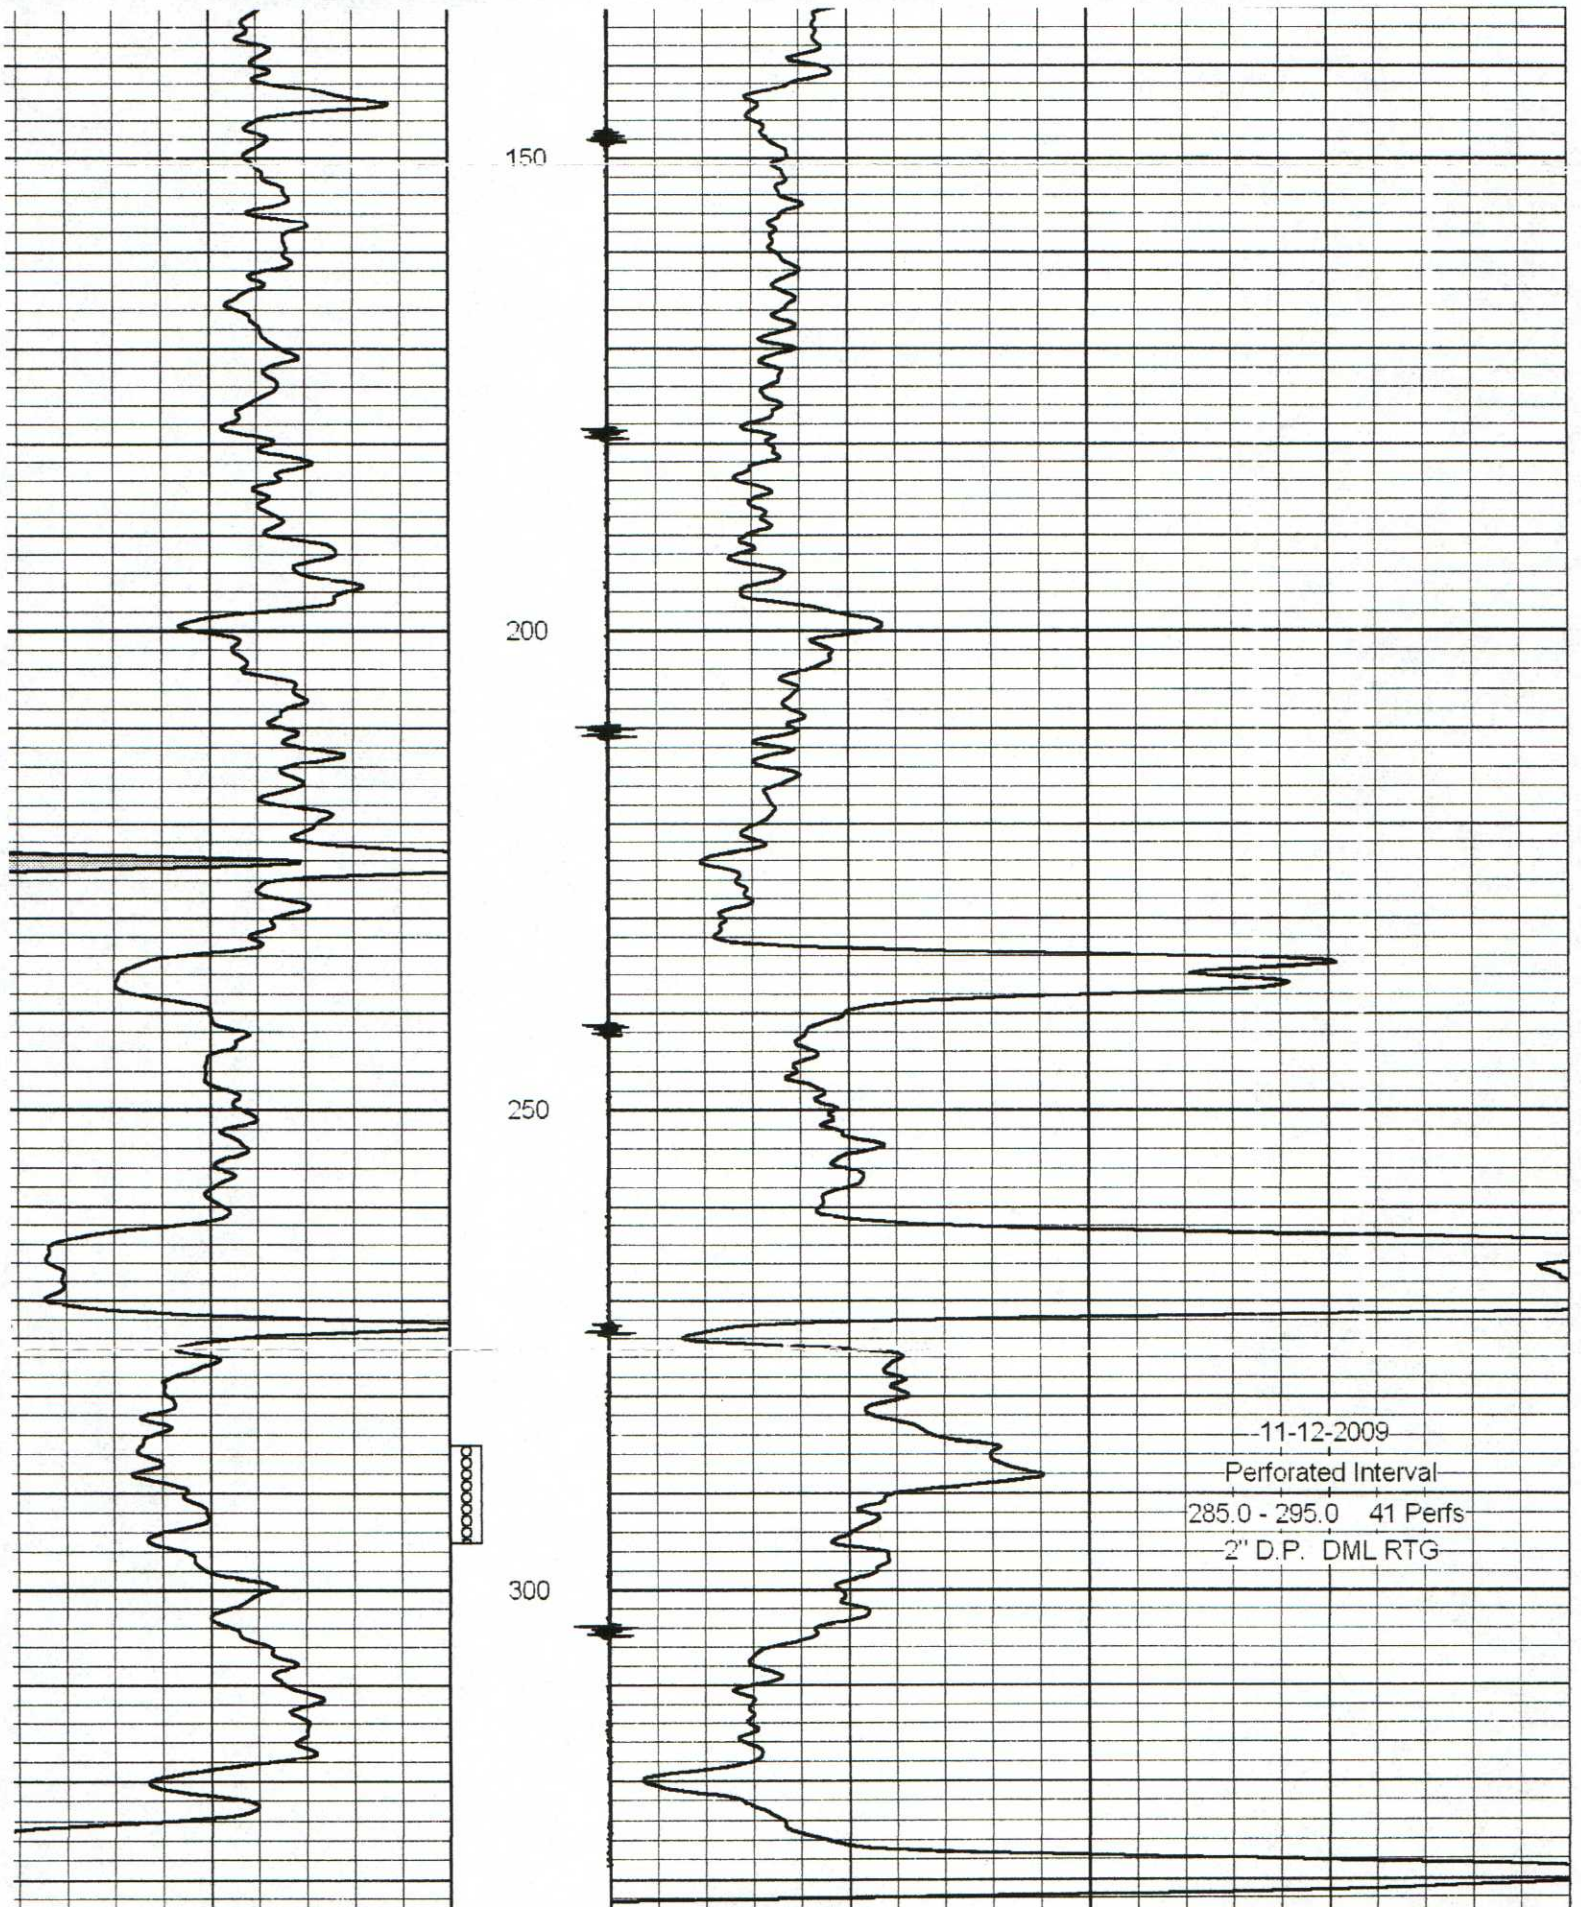

-11-12-2009  
 Perforated Interval  
 285.0 - 295.0 41 Perfs  
 2" D.P. DML RTG

Gamma Ray 150

Gamma Ray 300

100

Neutron

1800